


HAROLD H. KOLB

REGISTERED PROFESSIONAL LAND SURVEYOR
LAKE GENEVA, WISCONSIN

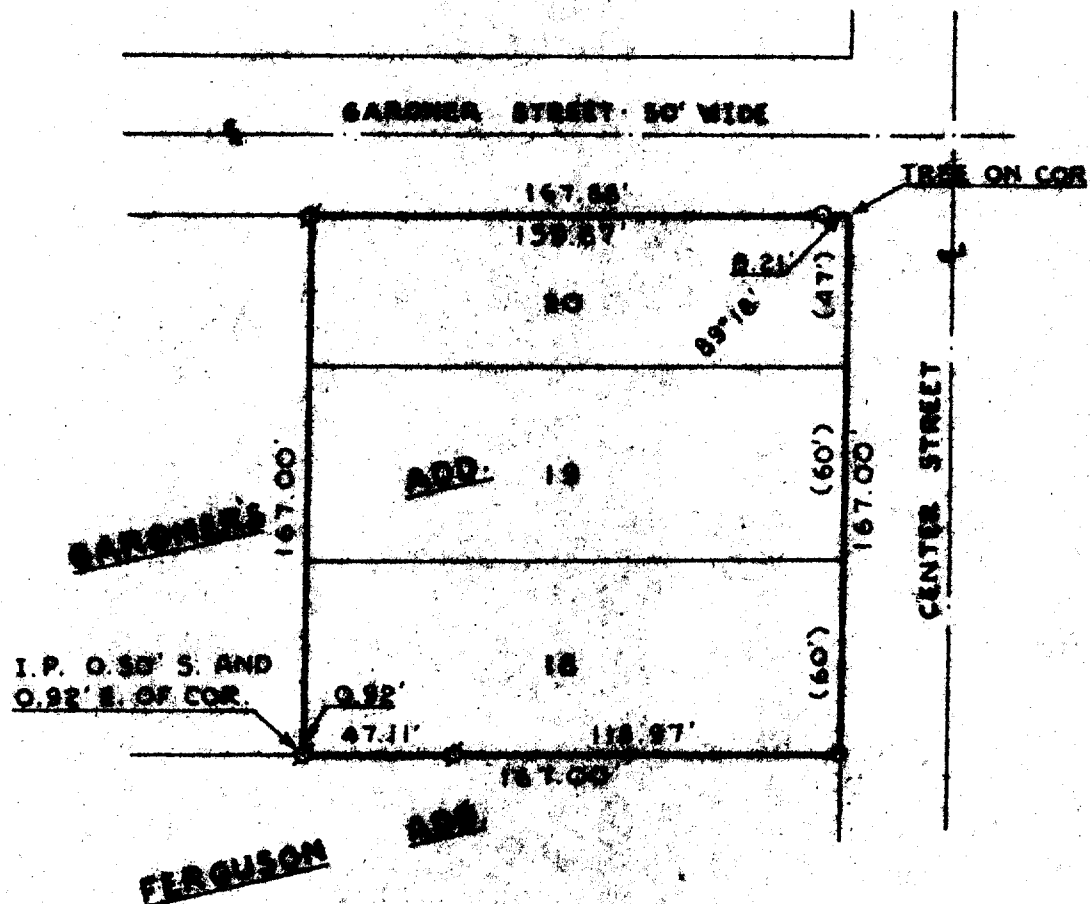

PLAT OF SURVEY OF

Lots 18, 19, and 20, Gardner's Addition
to the City of Lake Geneva, Walworth
County, Wisconsin.

N



SCALE: 1"=60'

LEGEND

- ⊕ - IRON PIPE POINT
- - IRON PIPE PLACED
- ⊙ - CONCRETE MONUMENT
- x - SPIKE
- () - AS PLATTED



I, HAROLD H. KOLB, DO HEREBY CERTIFY THAT I HAVE
SURVEYED THE PROPERTY HEREON DESCRIBED ACCORDING
TO THE OFFICIAL RECORDS AND THAT THE PLAT HEREON
IS A CORRECT REPRESENTATION OF THE LOT LINES.

Harold H. Kolb

HAROLD H. KOLB
WISCONSIN REGISTERED LAND SURVEYOR, 5-187
DATE June 11, 1974

26-13

7-480