


PLAT OF SURVEY
-OF-

LOT 28, EXCEPTING THEREFROM THE SOUTH 62 FEET, FERGUSON'S ADDITION TO THE CITY OF LAKE GENEVA,
WALWORTH COUNTY, WISCONSIN.

SURVEY FOR: KRISTIN STAHLAK
SURVEY ADDRESS: 723 WILLIAMS STREET, LAKE GENEVA, WI 53147


NOTE: REFER TO A CURRENT TITLE REPORT FOR
EASEMENTS, RESTRICTIONS OR COVENANTS WHICH
MAY AFFECT THIS PROPERTY.

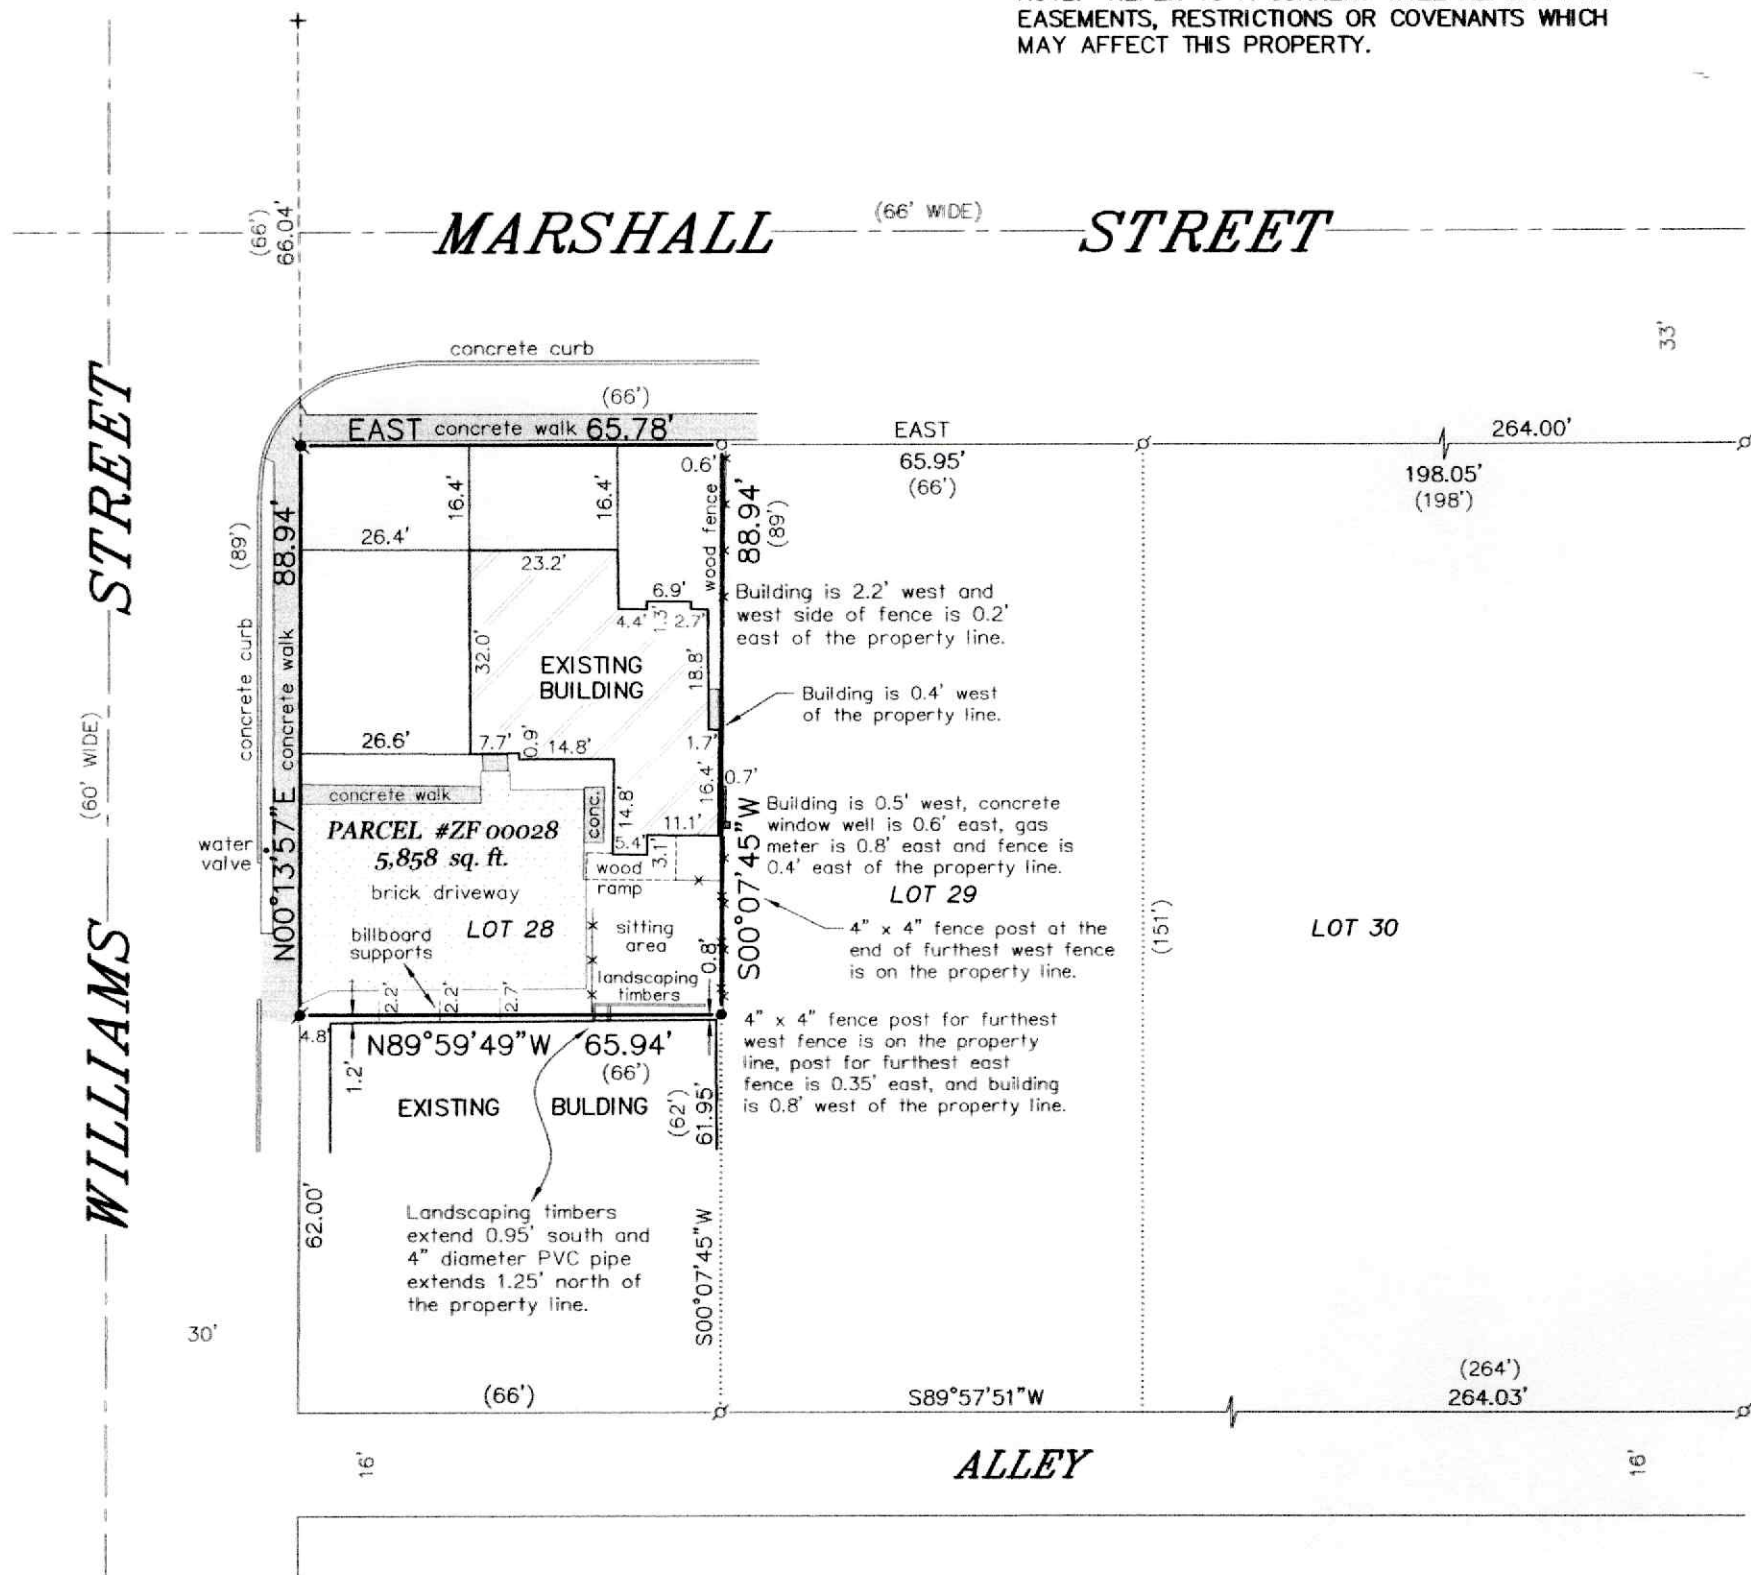

LEGEND

- FOUND 1-5/16" O.D. IRON PIPE
- ⌘ FOUND 1" O.D. IRON PIPE
- ◆ FOUND 3/4" DIA. IRON ROD
- ⌘ FOUND 1/2" DIA. IRON ROD
- + FOUND CROSSCUT
- SET 3/4" DIA. IRON ROD
- () RECORDED AS

BEARINGS HEREON RELATE TO THE SOUTH RIGHT-OF-WAY
LINE OF MARSHALL STREET. ASSUMED BEARING OF EAST.

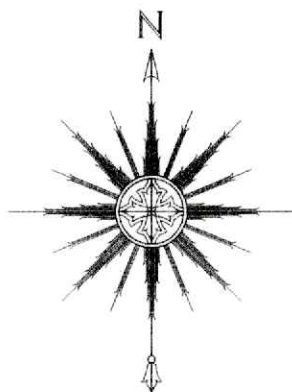


THIS IS NOT AN ORIGINAL PRINT
UNLESS THIS SEAL IS RED.

Thomas L. Satter
THOMAS L. SATTER S-2850

"I HEREBY CERTIFY THAT I HAVE SURVEYED THE ABOVE
DESCRIBED PROPERTY AND THAT THE ABOVE MAP IS A
CORRECT REPRESENTATION THEREOF AND SHOWS THE SIZE
AND LOCATION OF THE PROPERTY, ITS EXTERIOR
BOUNDARIES, THE LOCATION OF ALL VISIBLE STRUCTURES
AND DIMENSIONS OF ALL PRINCIPAL BUILDINGS THEREON,
BOUNDARY FENCES, APPARENT EASEMENTS, ROADWAYS AND
ENCROACHMENTS, IF ANY."

"THIS SURVEY IS MADE FOR THE USE OF THE PRESENT
OWNERS OF THE PROPERTY, AND THOSE WHO PURCHASE,
MORTGAGE, OR GUARANTEE THE TITLE THERETO WITHIN ONE
YEAR FROM DATE HEREOF."

SATTER SURVEYING, LLC
LAND SURVEYS, MAPPING AND PLANNING
272 ORIGIN STREET
BURLINGTON, WI 53105
262-661-4239

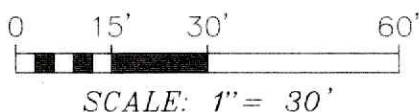

JULY 20, 2026
DATE

062606
JOB NUMBER