


HAROLD H. KOLB

REGISTERED PROFESSIONAL LAND SURVEYOR
LAKE GENEVA, WISCONSIN



N

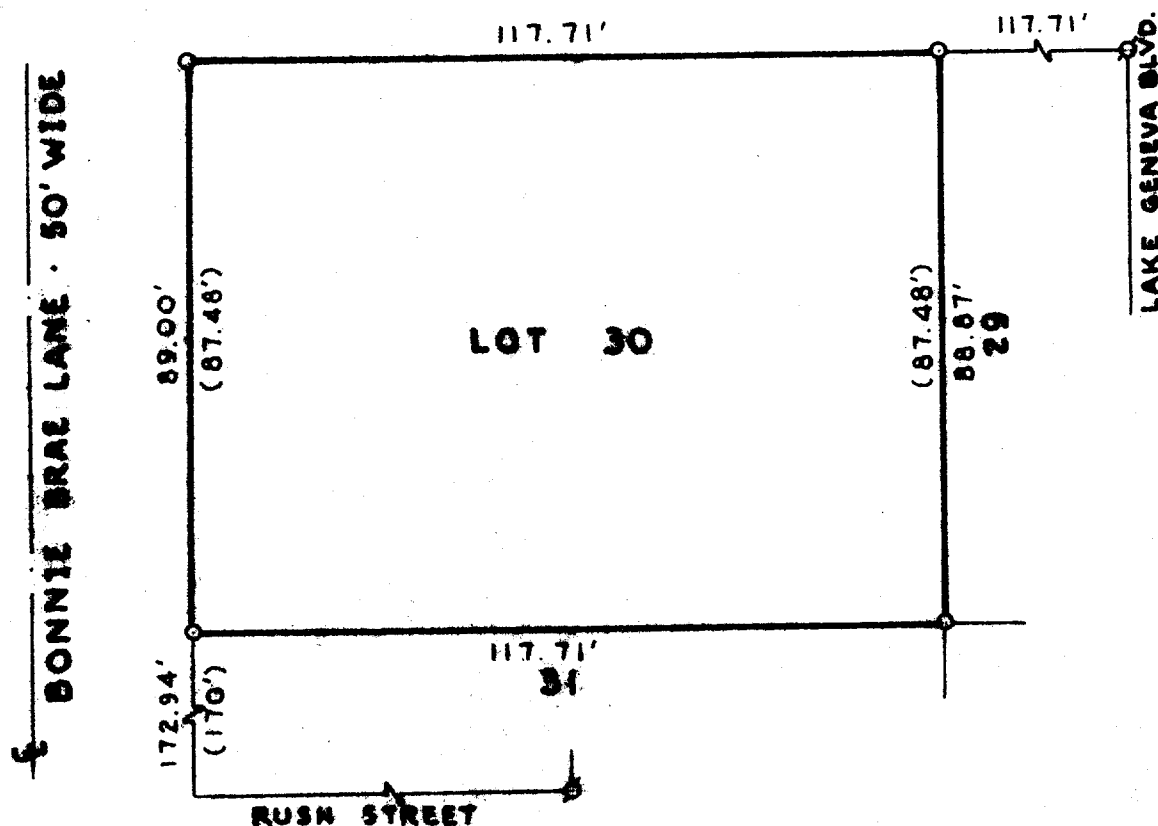

SCALE: 1"=30'

LEGEND

- phi - IRON PIPE FOUND
- o - IRON PIPE FLAGGED
- bullet - CONCRETE MONUMENT
- x - SPIKE
- (c) - Blatted



PLAT OF SURVEY OF

Lot 30, H. E. Wells Addition to
the City of Lake Geneva, Walworth
County, Wisconsin.

NOTE: Over-run and under-run has been
proportioned between existing iron pipe.

I, HAROLD H. KOLB, DO HEREBY CERTIFY THAT I HAVE
SURVEYED THE PROPERTY HEREON DESCRIBED ACCORDING
TO THE OFFICIAL RECORDS, AND THAT THE PLAT HEREON
IS A CORRECT REPRESENTATION OF THE LOT LINES.

Harold H. Kolb

HAROLD H. KOLB
WISCONSIN REGISTERED LAND SURVEYOR, S-187
DATE May 16, 1974

ZWS-30

7-483