


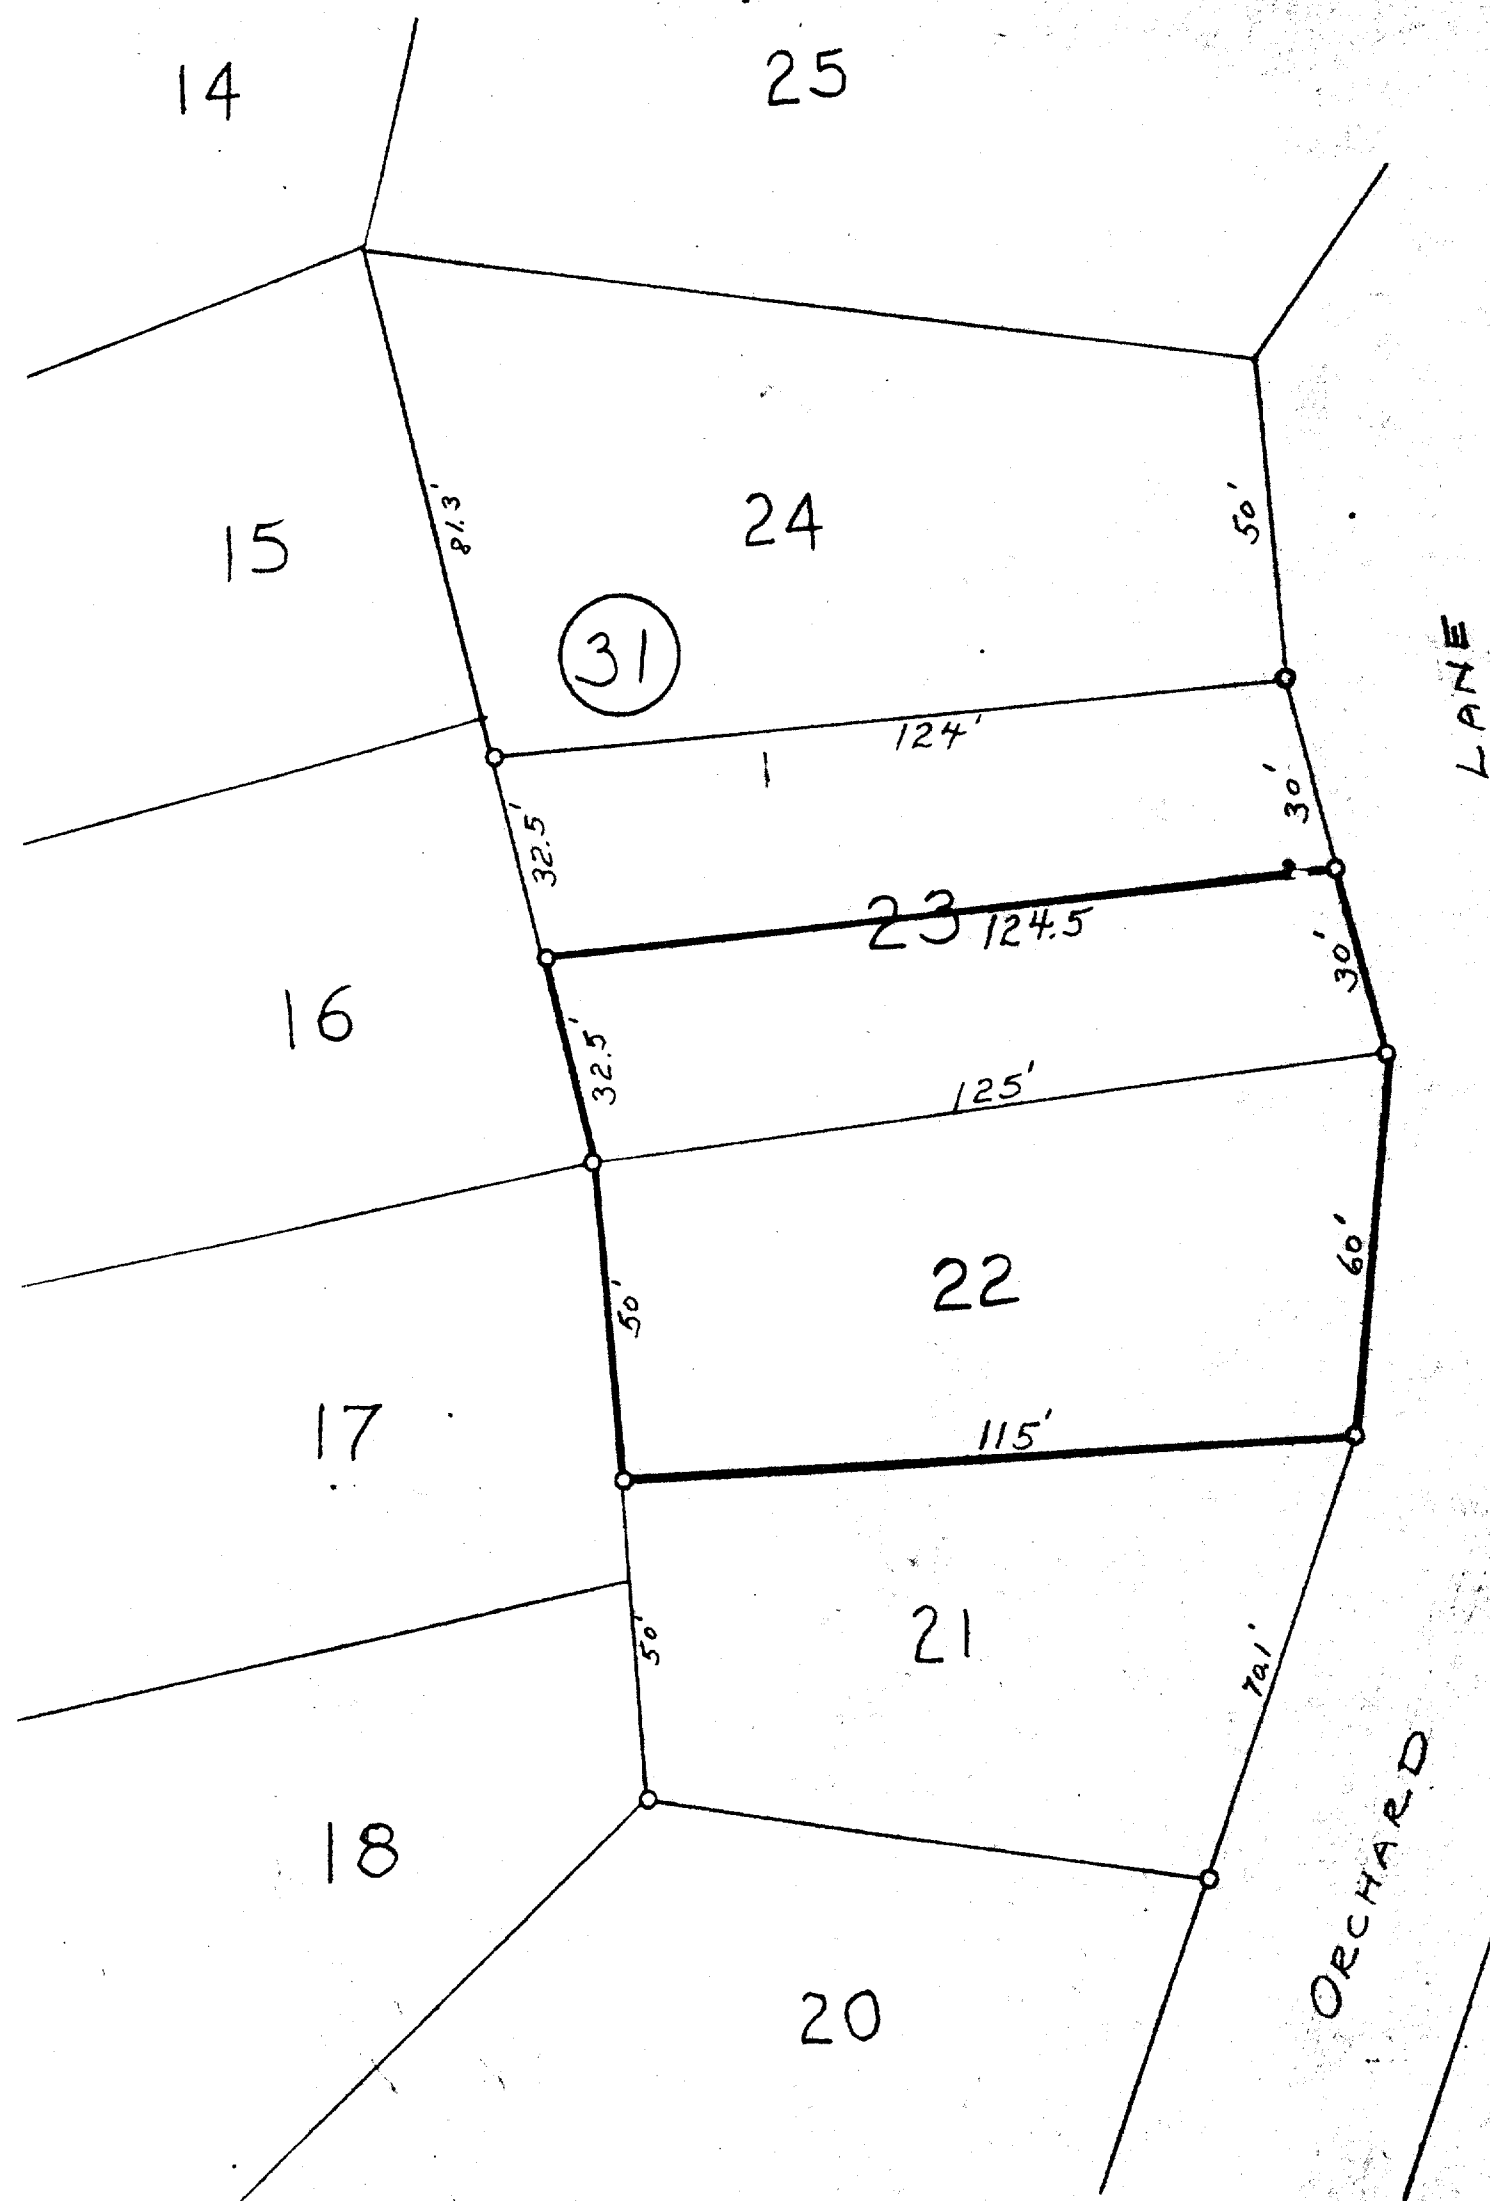

(21)

○ - IRON PIPE

PLAT OF SURVEY OF

LOT 22 AND THE SOUTHERLY $\frac{1}{2}$ OF LOT 23
OF BLOCK 31

LAKE GENEVA MANOR

LOCATED IN THE

CITY OF LAKE GENEVA

WALWORTH COUNTY, WISCONSIN

Raymond J. Gorman

ZLM-79 of
ZLM-80 (part of)

7-488

SCALE 1" = 30'

DATE May 1956