


HAROLD H. KOLB

REGISTERED PROFESSIONAL LAND SURVEYOR
LAKE GENEVA, WISCONSIN

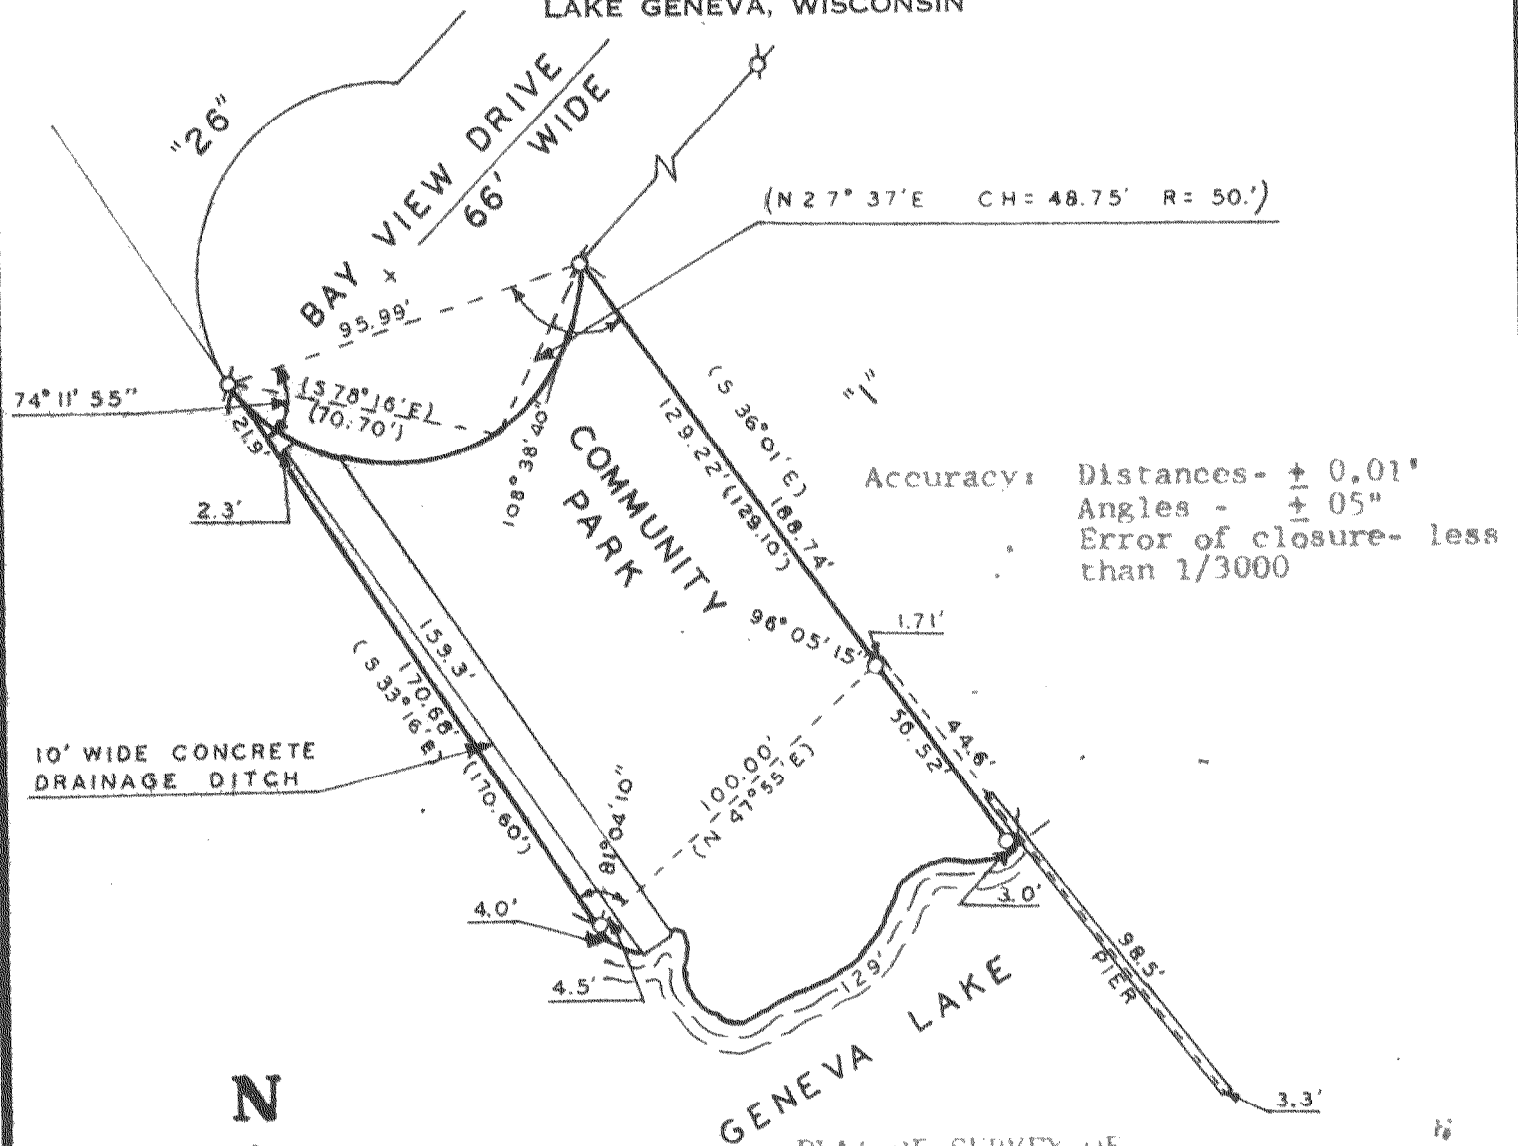

SCALE: 1" = 50'

PLAT OF SURVEY OF
The Community Park, Block 1 of Geneva Bay Estates, A Sub-division located in the City of Lake Geneva and in Section 2, T 1 N, R 17 E, and Section 35, T 2 N, R 17 E, Walworth County, Wisconsin.


LEGEND

- φ — IRON PIPE FOUND
- — IRON PIPE PLACED
- — CONCRETE MONUMENT
- x — SPIKE
- () — PLATTED DISTANCE

OWNER: Geneva Bay Estates Assn.

ORDERED BY: Milt Kelch

I, HAROLD H. KOLB, DO HEREBY CERTIFY THAT I HAVE SURVEYED THE PROPERTY HEREON DESCRIBED ACCORDING TO THE OFFICIAL RECORDS, AND THAT THE PLAT HEREON IS A CORRECT REPRESENTATION OF THE LOT LINES.

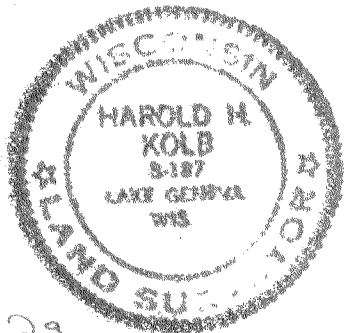

Harold H. Kolb

HAROLD H. KOLB
WISCONSIN REGISTERED LAND SURVEYOR, S-187
DATE July 26, 1974