


N
 SCALE 1"=20'
 0: IRON PIPE

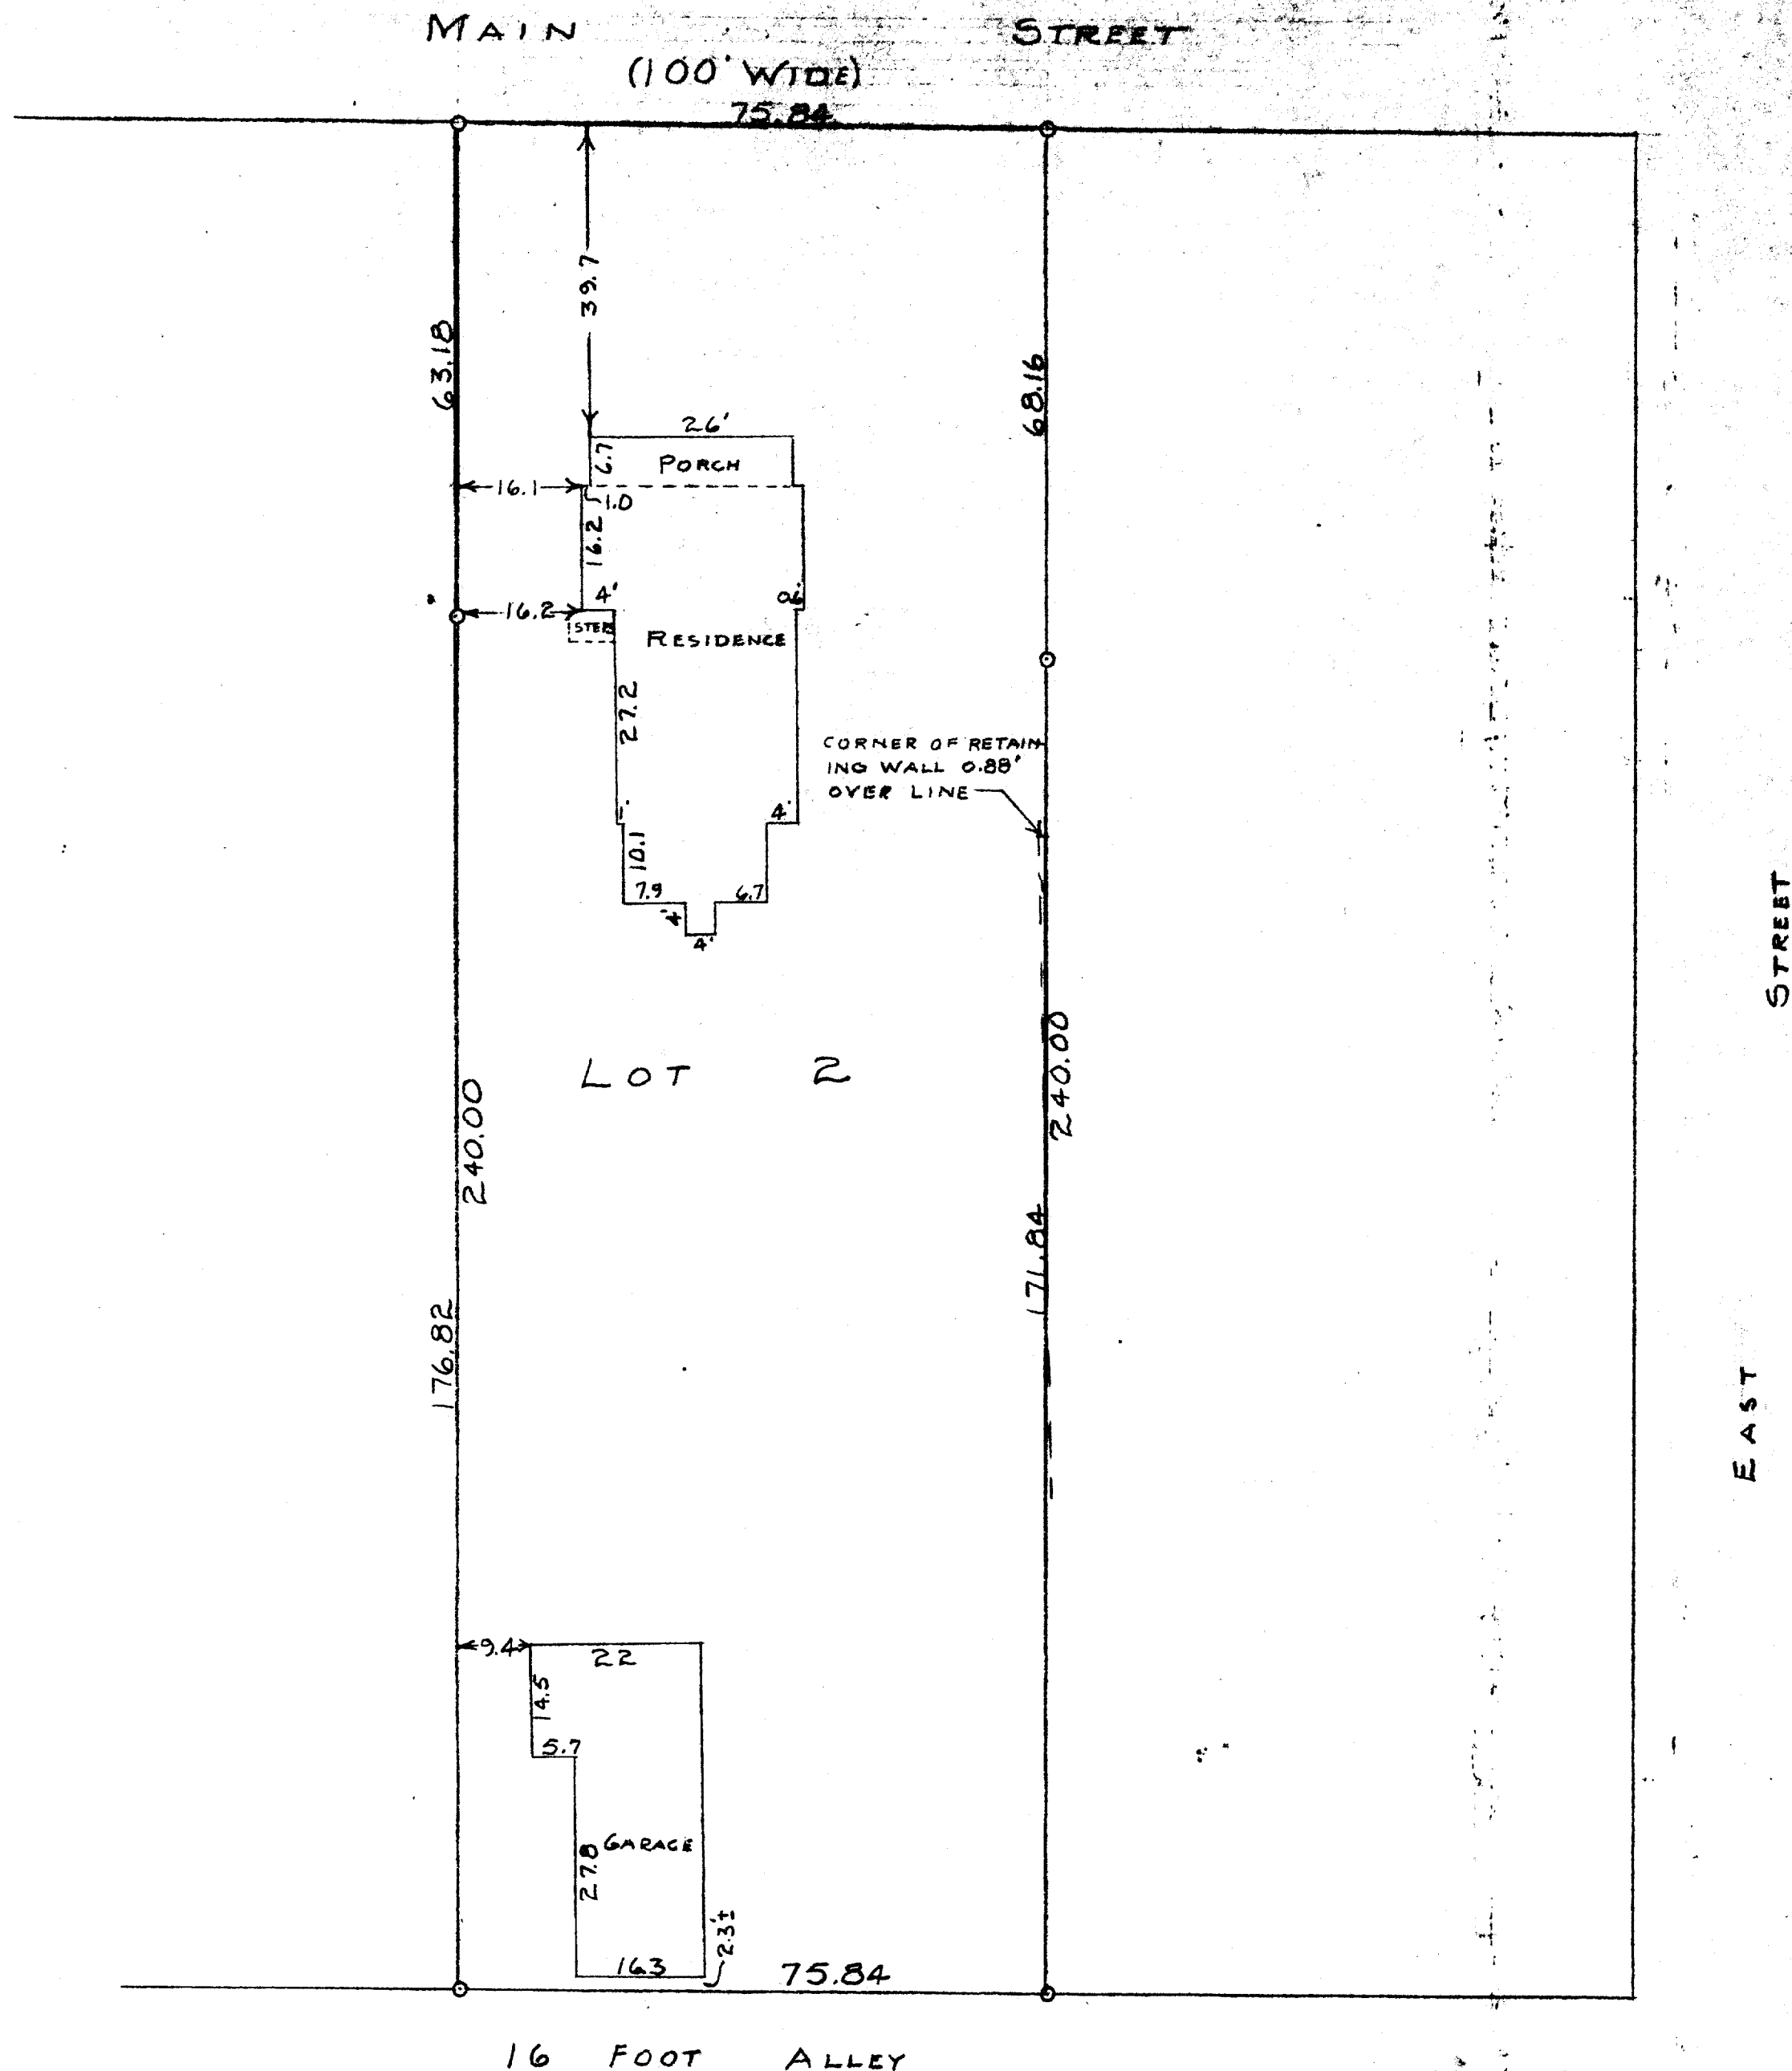

STATE OF WISCONSIN) ss
 WALWORTH COUNTY)

I, GEORGE T. DUNHAM, DO HEREBY CERTIFY THAT I HAVE SURVEYED THE
 PROPERTY DESCRIBED AS FOLLOWS, TO-WIT:

LOT 2, BLOCK 2 OF E.D. PHILLIPS SUBDIVISION LOCATED IN THE
 CITY OF LAKE GENEVA, WALWORTH COUNTY, WISCONSIN.

AND THAT THE PLAT SHOWN ABOVE IS A CORRECT REPRESENTATION OF THE PROPERTY
 LINES AND OF THE IMPROVEMENTS LOCATED THEREON

MAY 1958

NOW C.T.

George T. Dunham
 GEORGE T. DUNHAM, SURVEYOR
 DELAVER, WISC.

7-52