


May 19 & 20-1938
 Wm. F. Gruber
 Survey of S. 1/2 Lot 6
 Block 12, Original plat
 Geneva Village

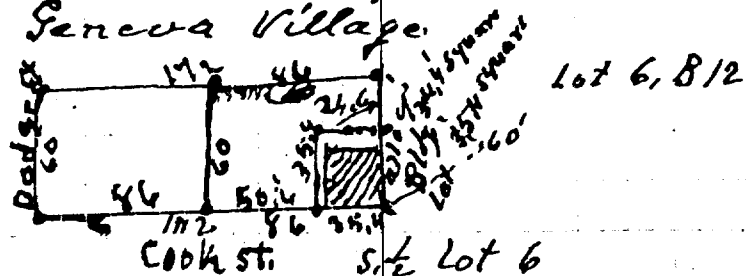

Block 360' N. line W. line 1' inside walk

Bldg 34.4' sq. lot 35.4' sq.

Remaining lot, N. line 60', W. line 50.6'

and 25.4' S. line & line 86'

S. line 24.6' 6' iron stks

Cook St. 80' wide

Dodge 79' "

Alley 16' "

N. line Block 12 360'

S. line " 2 360' to a point

W. side, 3' in walk west side

S. & Cor. B, 2 Mon. conc 5" in dia.

another " Conc. Mon. 60' west of lot,

2 B. ps to Gruber May 24

Charges, \$5. Paid

Blue prints delivered 5-25

See record A- P. 8

B. P. A2 Plat A2 Page 8

OP-98 + OP-99

7-520-lk