


**REGISTERED PROFESSIONAL LAND SURVEYOR
LAKE GENEVA, WISCONSIN**

LOT 13, DJN-ROMIN SUBDIVISION, T1N,
R18E, CITY OF LAKE GENEVA, WALWORTH
COUNTY, WISCONSIN

NOTE: ALL IRON PIPE FOUND TO BE WITHIN
0.10' OF PLATTED DISTANCES.

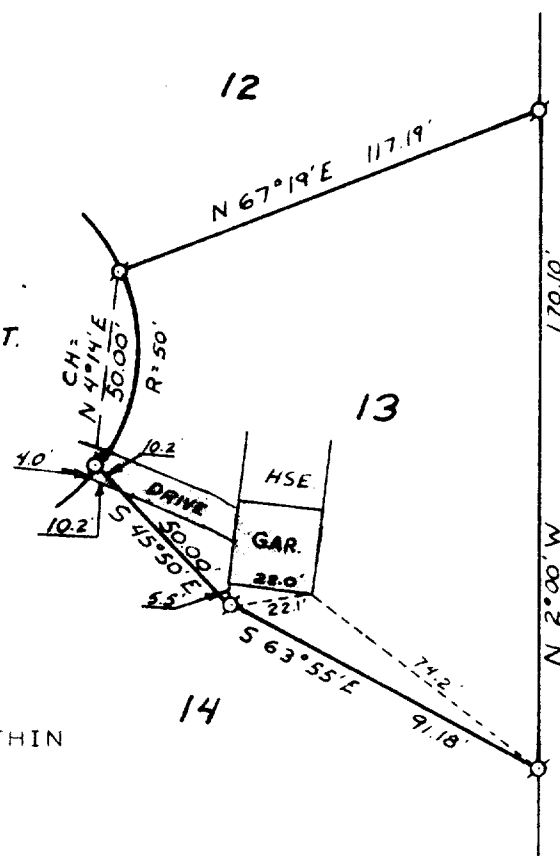

OWNER: BILL JOHNSON
BOX 609
LAKE GENEVA, WI 53147


'ACCURACY: DISTANCE $\pm 0.01'$
 ANGLES $\pm 05''$
 ERROR OF CLOSURE LESS THAN
 1/3000



SCALE - 1" = 50'

LEGEND

- φ — IRON PIPE FOUND
 O — IRON PIPE PLACED
 ● — CONCRETE MONUMENT
 X — SPIKE

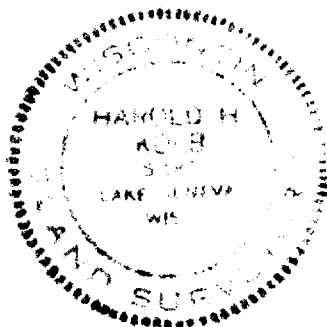

I, HAROLD H. KOLB, DO HEREBY CERTIFY THAT I HAVE SURVEYED THE PROPERTY HEREON DESCRIBED ACCORDING TO THE OFFICIAL RECORDS AND THAT THE PLAT HEREON IS A CORRECT REPRESENTATION OF THE LOT LINES.

Harold H. Kolb
HAROLD H. KOLB
WISCONSIN REGISTERED LAND SURVEYOR, S-187
DATE Aug 26, 1975

ZDA-13

BRUNING 40-105 1M-6-71

7-522