


MILLER ROAD - 60' WIDE

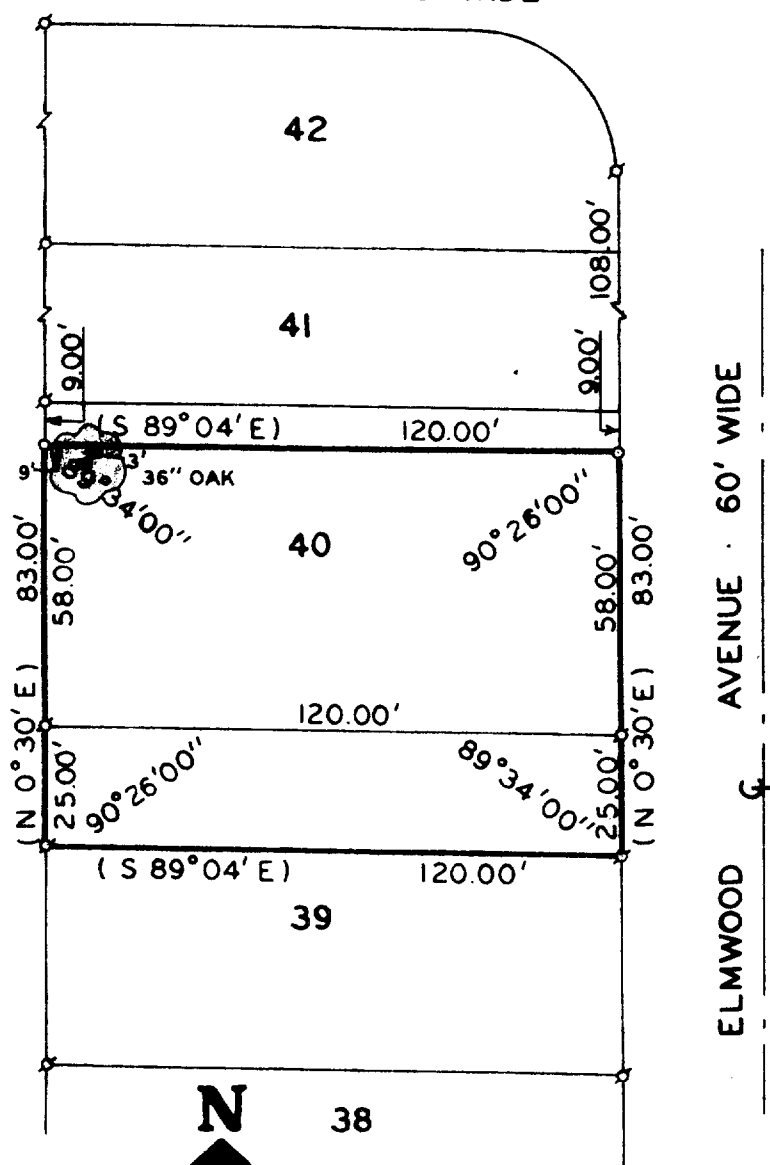

N

38

SCALE: 1" = 40'

LEGEND

- ϕ — IRON PIPE FOUND
 O — IRON PIPE PLACED
 ● — CONCRETE MONUMENT
 x — SPIKE
 () — AS PLATTED



PLAT OF SURVEY OF

THE NORTH 25.00 FEET OF
LOT 39 AND THE SOUTH 58.00
FEET OF LOT 40, STURWOOD
SUBDIVISION, CITY OF LAKE
GENEVA, WALWORTH COUNTY,
WISCONSIN.

OWNER: EDWARD WEINBERG

ACCURACY: DISTANCE $\pm 0.01'$
 ANGLES $\pm 05''$
 ERROR OF CLOSURE
 LESS THAN $1/3000$

I, HAROLD H. KOLB, DO HEREBY CERTIFY THAT I HAVE SURVEYED THE PROPERTY HEREON DESCRIBED ACCORDING TO THE OFFICIAL RECORDS, AND THAT THE PLAT HEREON IS A CORRECT REPRESENTATION OF THE LOT LINES.

Harold H. Roth

HAROLD H. KOLB
WISCONSIN REGISTERED LAND SURVEYOR, S-187

DATE Aug 28, 1975

REVISED: ✓ SEPT. 11, 1975

ST-39

7-526