


KOLB LAND CONSULTING, INC.
LAND SURVEYING • SUBDIVIDING • LAND PLANNING

LAKE GENEVA, WISCONSIN 53147

WHITEWATER, WISCONSIN 53190

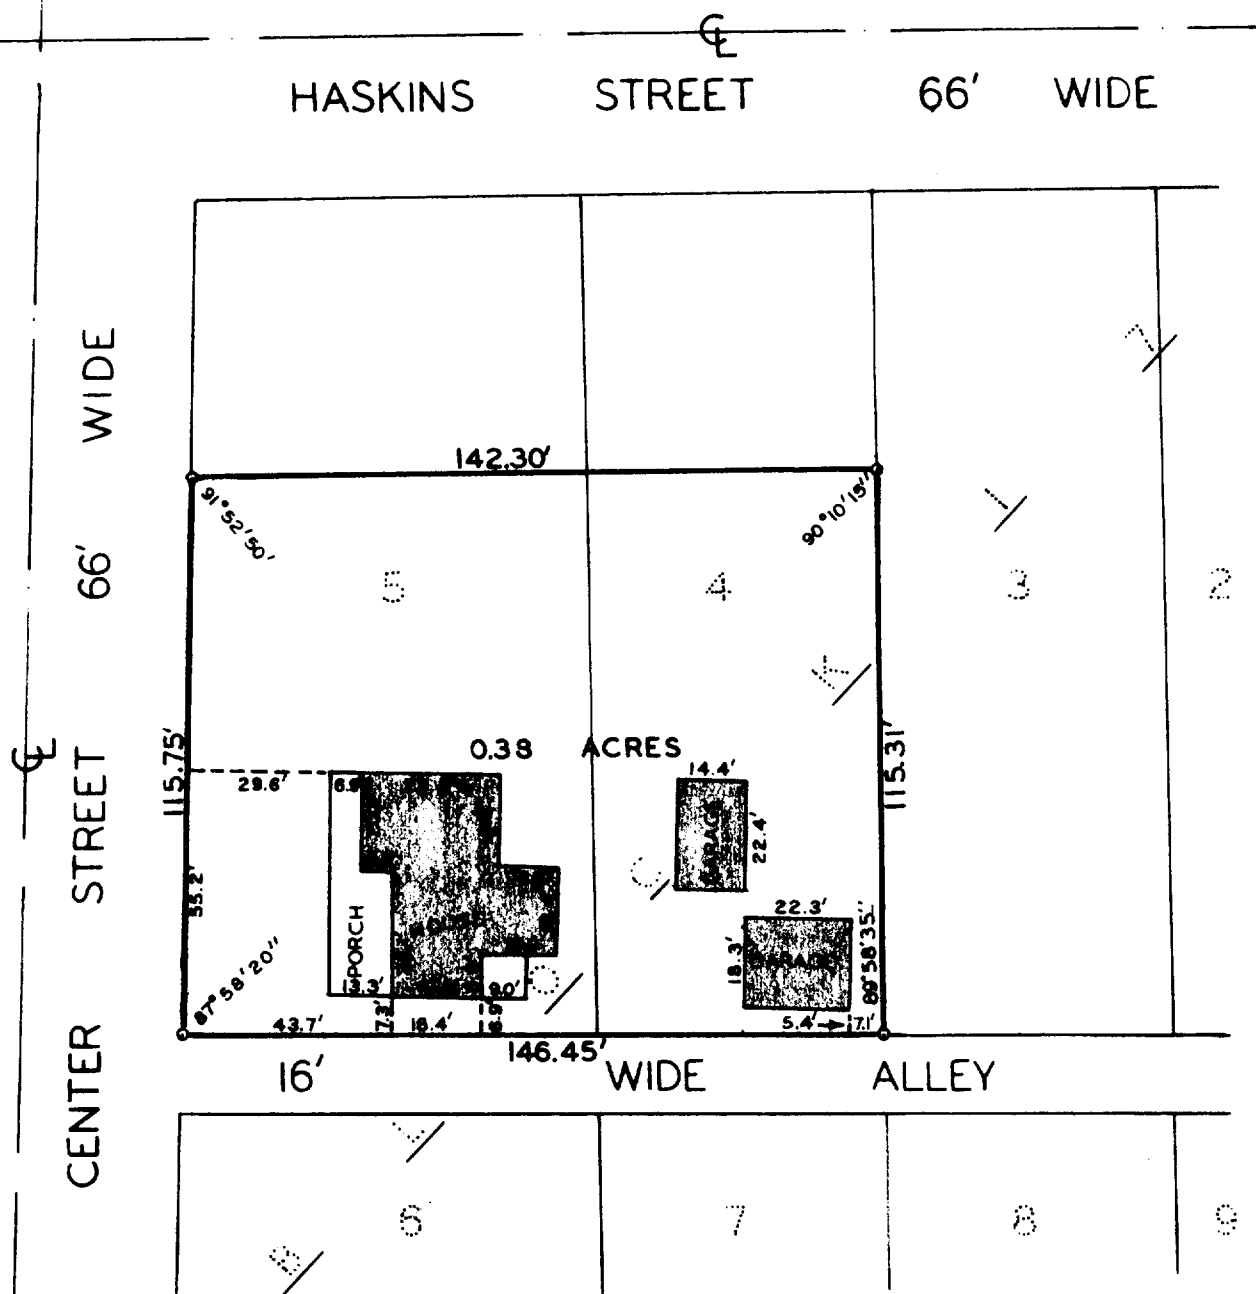


PLAT OF SURVEY OF

THE SOUTH 7/8 OF LOTS 5 AND 6, BLK 17, GENEVA
LAKE CRAFTWORK MANUFACTURING COMPANY'S ADDITION,
LAKE GENEVA, WALWORTH COUNTY, WISCONSIN.

ORDERED BY: EDWIN A. FRANKLIN
804 CENTER STREET
LAKE GENEVA, WI. 53147



SCALE 1"=40'

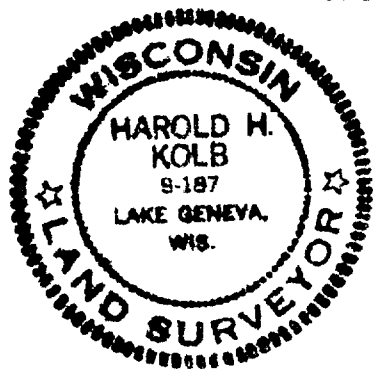

LEGEND:
○-IRON PIPE PLACED

Harold H. Kolb
HAROLD H. KOLB
WISCONSIN REGISTERED LAND SURVEYOR, S-187
DATE April 20, 1979

26C-84B

7-537K