


HAROLD H. KOLB

REGISTERED PROFESSIONAL LAND SURVEYOR
LAKE GENEVA, WISCONSIN

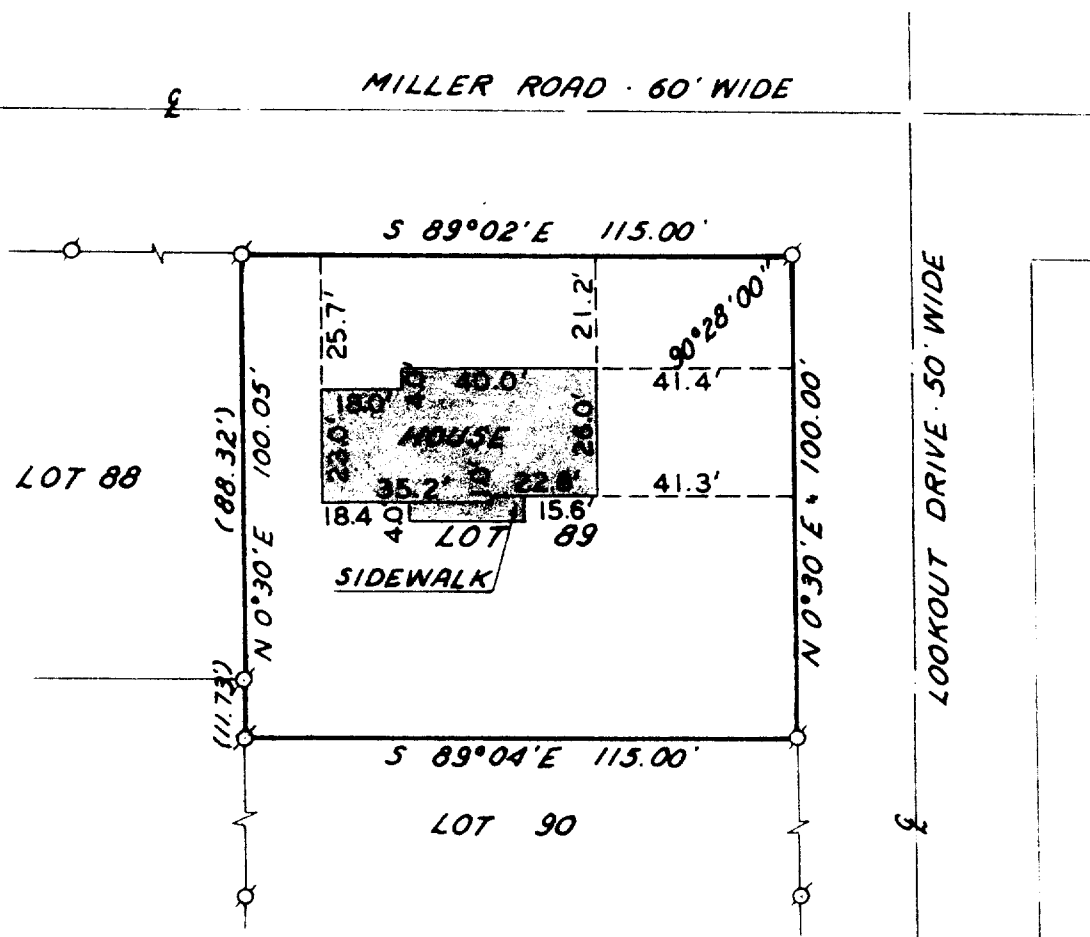

PLAT OF SURVEY OF

LOT 89, STURWOOD ADDITION NO. 3, CITY OF
LAKE GENEVA, WALWORTH COUNTY, WISCONSIN.

OWNER: HARRY BECKER

ACCURACY: DISTANCES: $\pm 0.01'$
ANGLES: $\pm 65''$
ERROR OF CLOSURE: LESS THAN ONE
PART IN 3,000

N



SCALE: 1"=40'

LEGEND

- φ — IRON PIPE FOUND
- — IRON PIPE PLACED
- — CONCRETE MONUMENT
- x — SPIKE
- () — RECORDED AS

I, HAROLD H. KOLB, DO HEREBY CERTIFY THAT I HAVE
SURVEYED THE PROPERTY HEREON DESCRIBED ACCORDING
TO THE OFFICIAL RECORDS, AND THAT THE PLAT HEREON
IS A CORRECT REPRESENTATION OF THE LOT LINES, AND
THE PRINCIPLE BUILDING LINES THEREON.

Harold H. Kolb

HAROLD H. KOLB
WISCONSIN REGISTERED LAND SURVEYOR, S-187
DATE March 18, 1976



25T3-25

7-549-A