


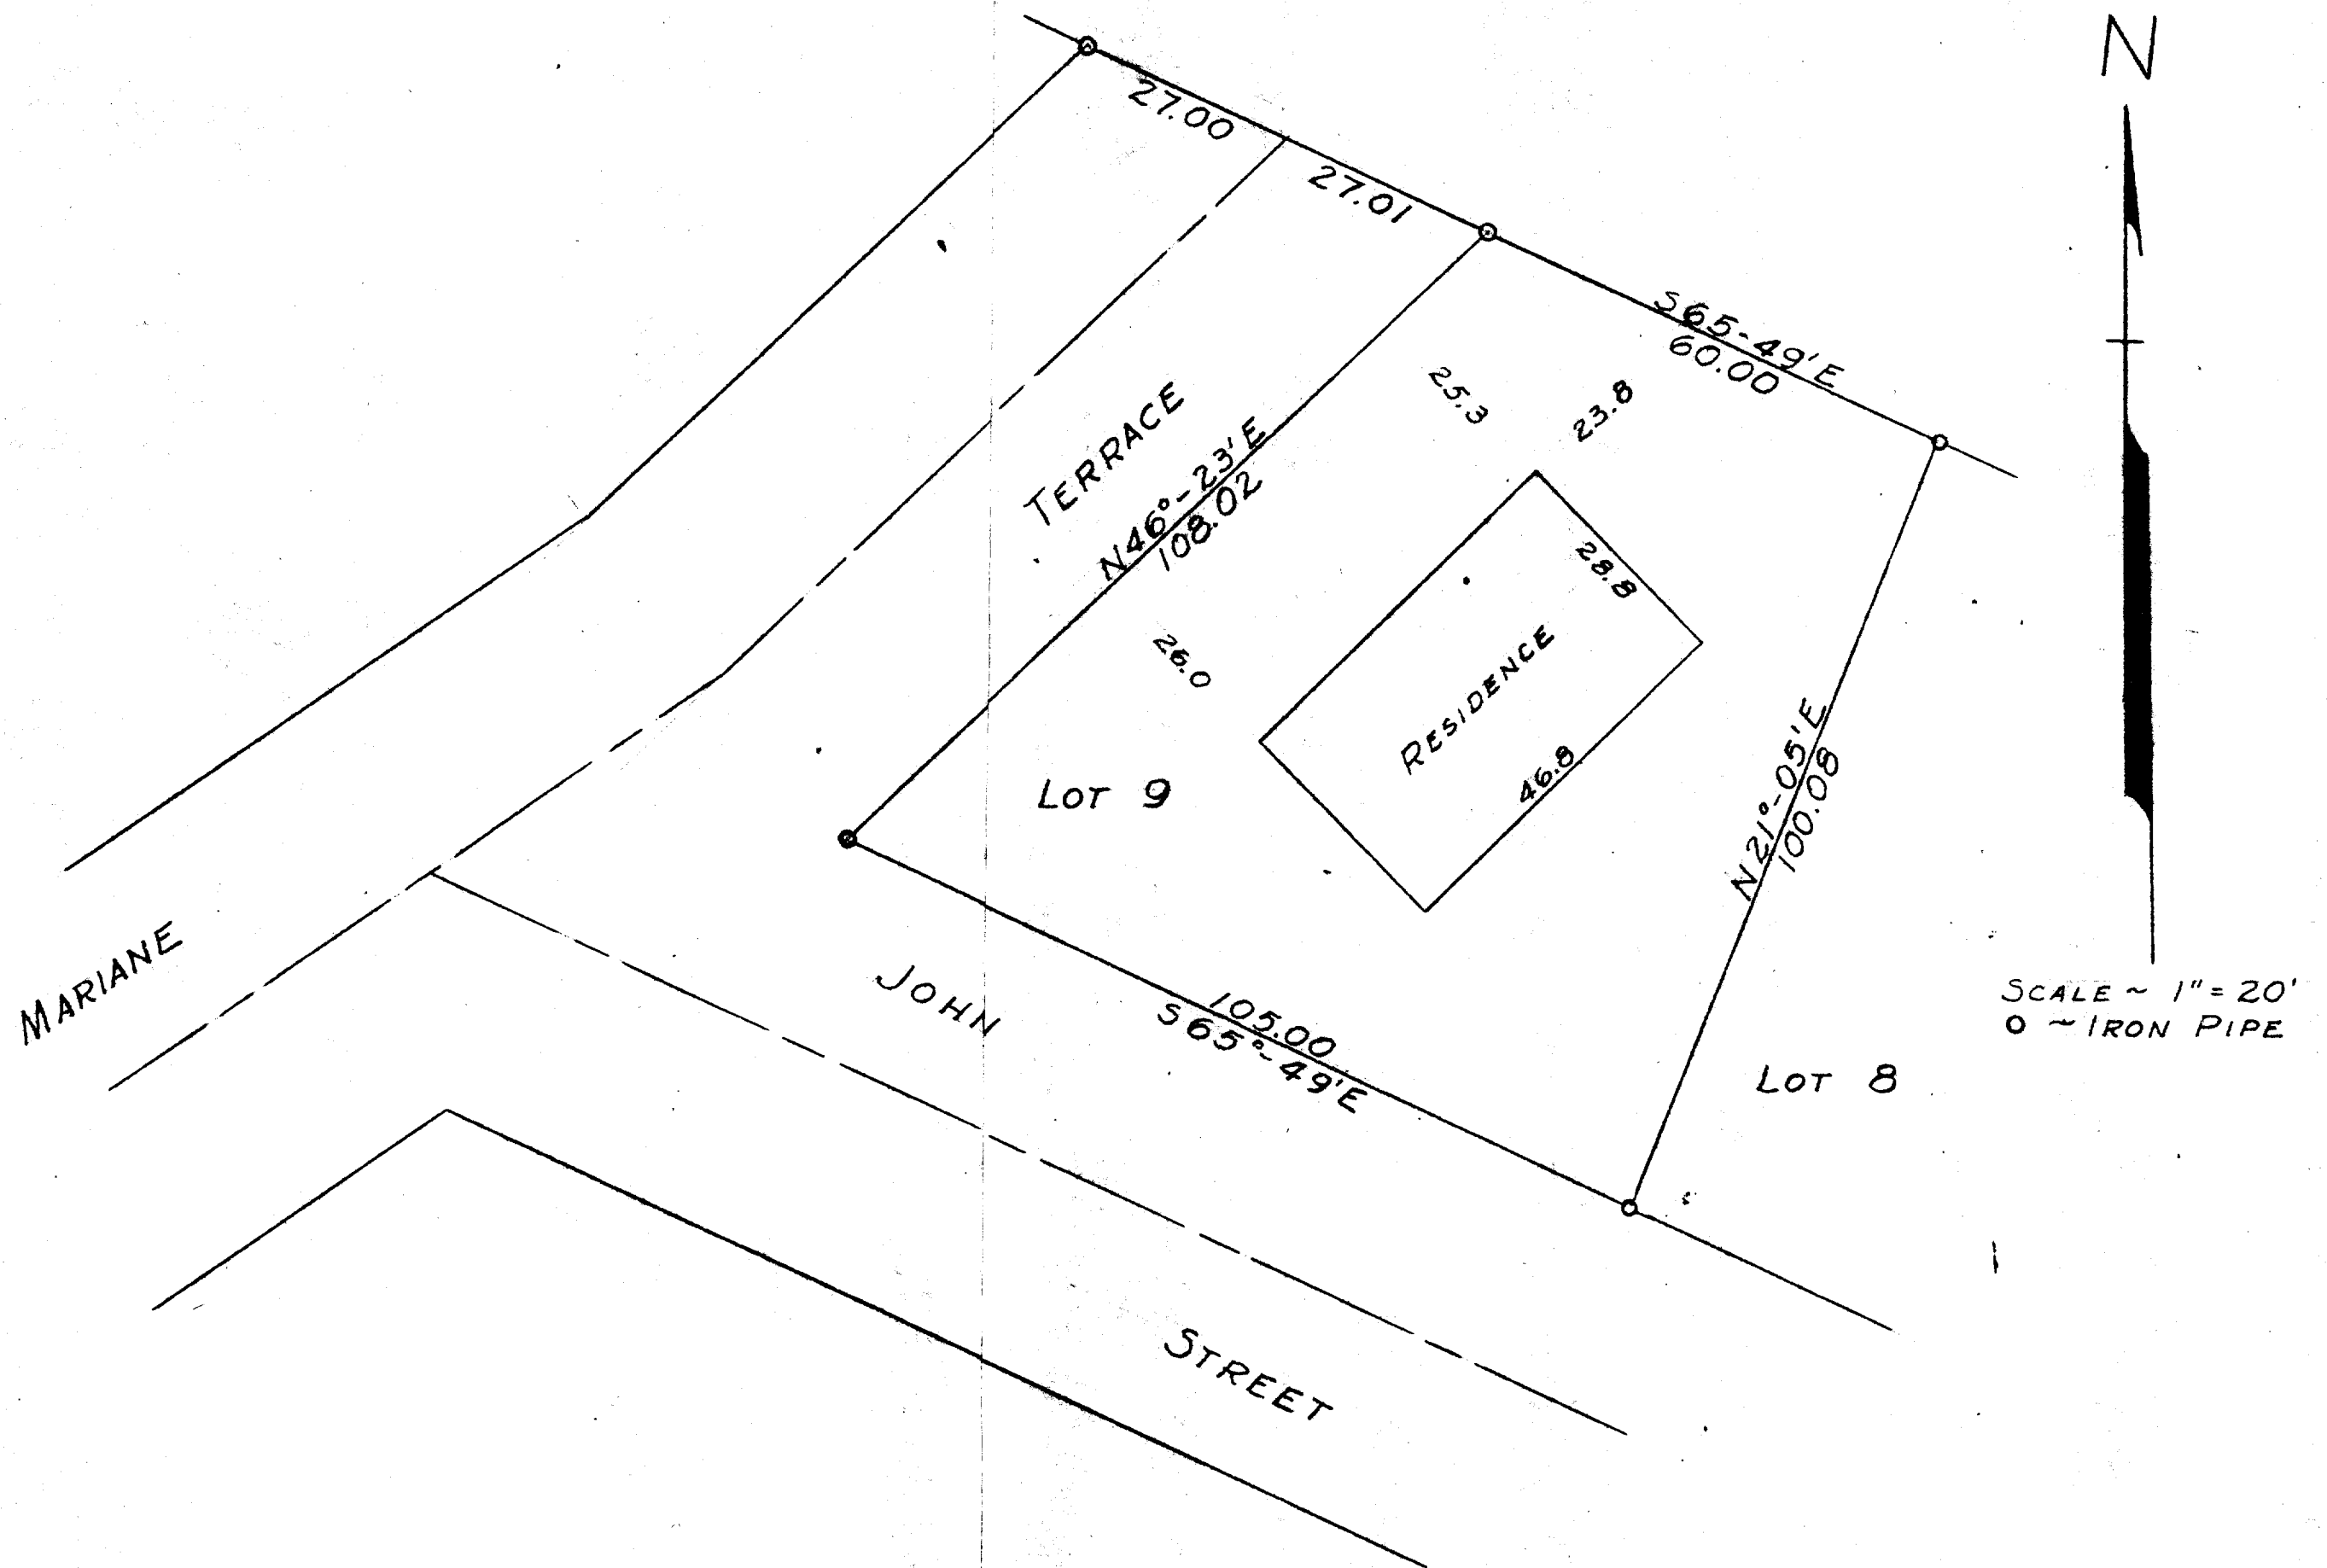

STATE OF WISCONSIN } S.S.
WALWORTH COUNTY }

I, GEORGE T. DUNHAM, DO HEREBY CERTIFY THAT I HAVE SURVEYED THE
PROPERTY DESCRIBED AS FOLLOWS:

LOT 9 OF SYVER-STAD LAKE SHORE ESTATES, LOCATED IN THE
CITY OF LAKE GENEVA, WALWORTH COUNTY, WISCONSIN.

AND THAT THE PLAT SHOWN ABOVE IS A CORRECT REPRESENTATION OF THE
PROPERTY LINES AND OF THE IMPROVEMENTS LOCATED THEREON.
MARCH 19, 1958

George T. Dunham
GEORGE T. DUNHAM, SURVEYOR
DELAVER, WISCONSIN