


HAROLD H. KOLB

REGISTERED PROFESSIONAL LAND SURVEYOR
LAKE GENEVA, WISCONSIN

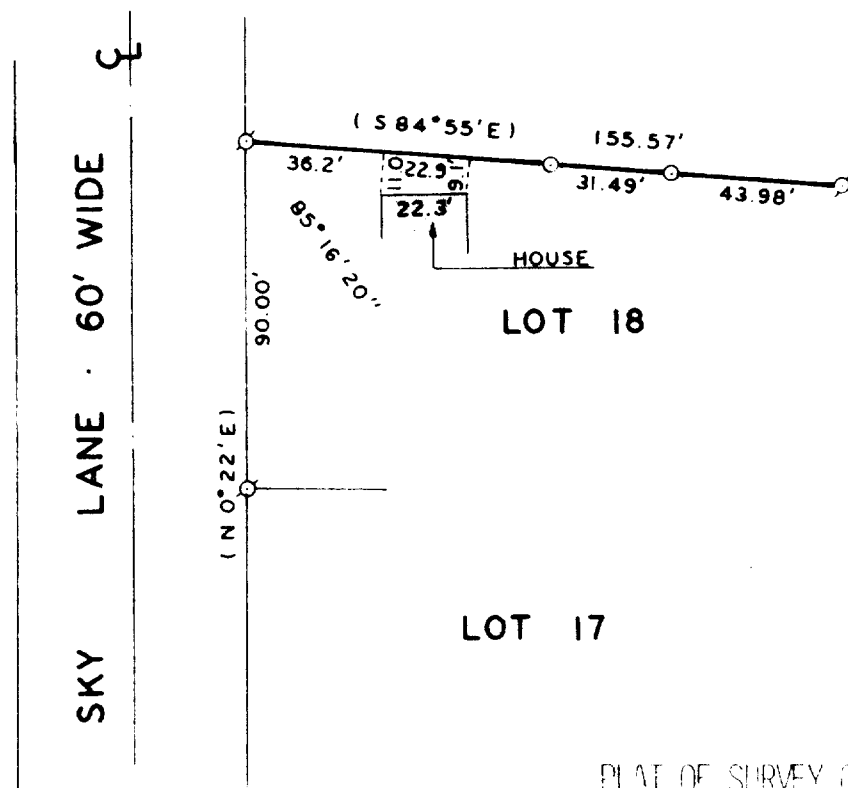

PLAT OF SURVEY OF

NORTH LINE OF LOT 18, STURWOOD ADDITION,
CITY OF LAKE GENEVA, SECTION 35, T24, R17,
WALWORTH COUNTY, WISCONSIN.

OWNER: KEVIN WALDECK

ACCURACY: DISTANCES: ± 1.01'
ANGLES: ± 05"
ERROR OF CLOSURE: LESS THAN
ONE PART IN 3000.

N




SCALE: 1" = 50'

LEGEND

- φ — IRON PIPE FOUND
- — IRON PIPE PLACED
- — CONCRETE MONUMENT
- x — SPIKE

() AS PLATTED

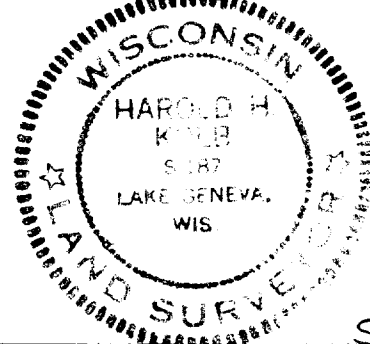

I, HAROLD H. KOLB, DO HEREBY CERTIFY THAT I HAVE
SURVEYED THE PROPERTY HEREON DESCRIBED ACCORDING
TO THE OFFICIAL RECORDS AND THAT THE PLAT HEREON
IS A CORRECT REPRESENTATION OF THE LOT LINES

Harold H. Kolb

HAROLD H. KOLB
WISCONSIN REGISTERED LAND SURVEYOR, S-187
DATE April 26, 1976

ST-17 (N Line)

7-556