



Highway 36

N

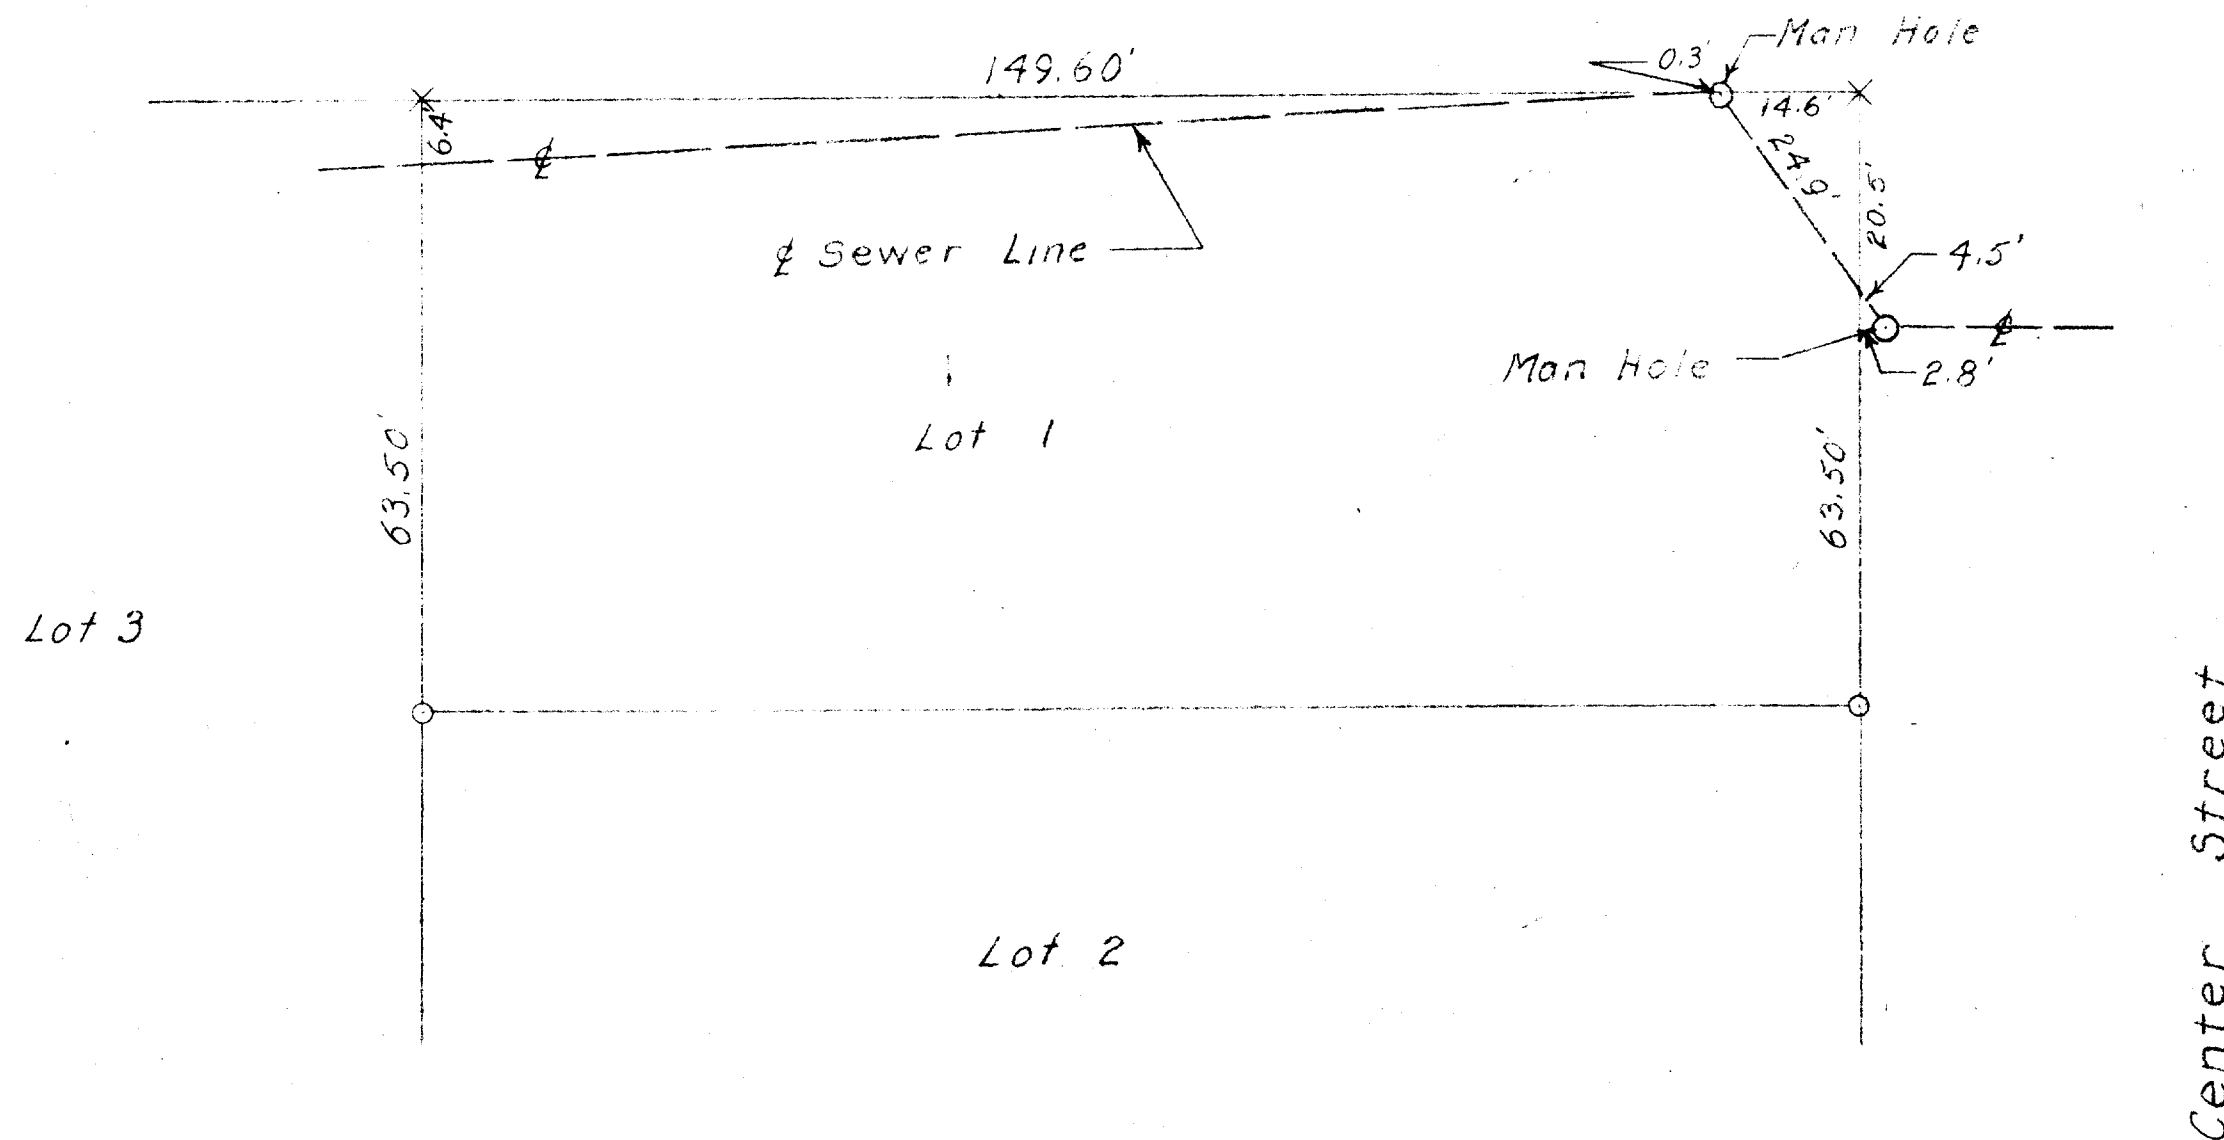

o - Iron Pipe
x - Cross Cut in Concrete

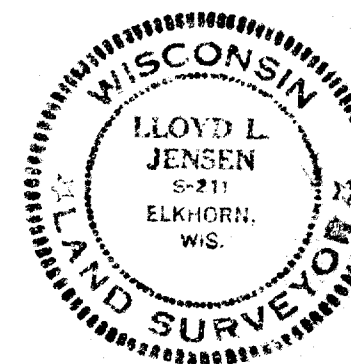

PLAT OF SURVEY OF

Lot 1, Warhurst's Subdivision, City
of Lake Geneva, Walworth County,
Wisconsin

Lloyd L. Jensen
SURVEYOR

SCALE 1" = 20'

DATE June 1957

24.2

7-56 J