

ROBERS & BOYD, INC.
CONSULTING ENGINEERS & LAND SURVEYORS


PHONE (414) 763-2652

116 E. CHESTNUT ST.

BURLINGTON, WIS. 53105


PLAT OF SURVEY AND BUILDING LOCATION
FOR
CY MILLER

The East 85 feet of the South 18.5 feet of Lot 3 and the East 85 feet of Lots A4 and A5 all in Block 5 of Phillips and Purvis, a subdivision to the City of Lake Geneva, Walworth County, Wisconsin.

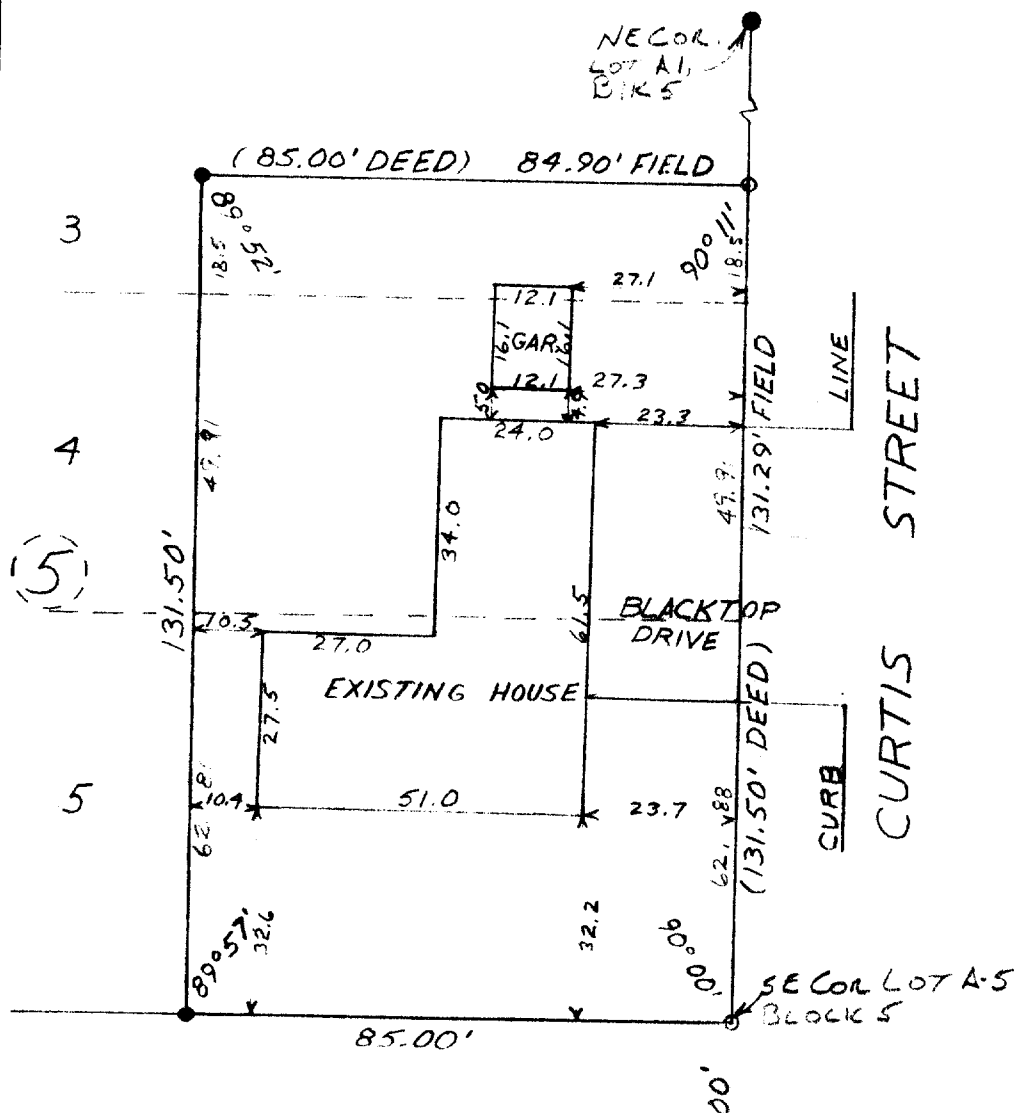

~ LEGEND ~

- FOUND 1 3/4" O.D. IRON PIPE
- SET 1 1/4" O.D. IRON PIPE
- FOUND 1" O.D. IRON PIPE
- SCALE - 1" = 30'

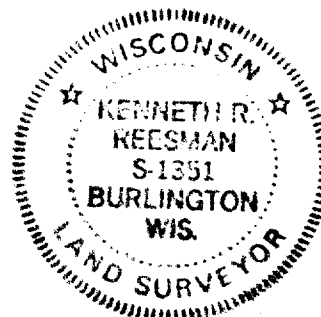

I HEREBY CERTIFY THAT WE HAVE SURVEYED THE LANDS DESCRIBED ABOVE ACCORDING TO OFFICIAL RECORDS AND THAT THE PLAT DRAWN HEREON IS A CORRECT REPRESENTATION OF SAID SURVEY.

Kenneth R. Reesman
WIS. REG. LAND SURVEYOR

DATE 11-2-76

JOB NO. 76207