


DUNHAM SURVEYING, S.C.
SURVEYING & SUBDIVIDING
DELAVER, WISCONSIN 53115

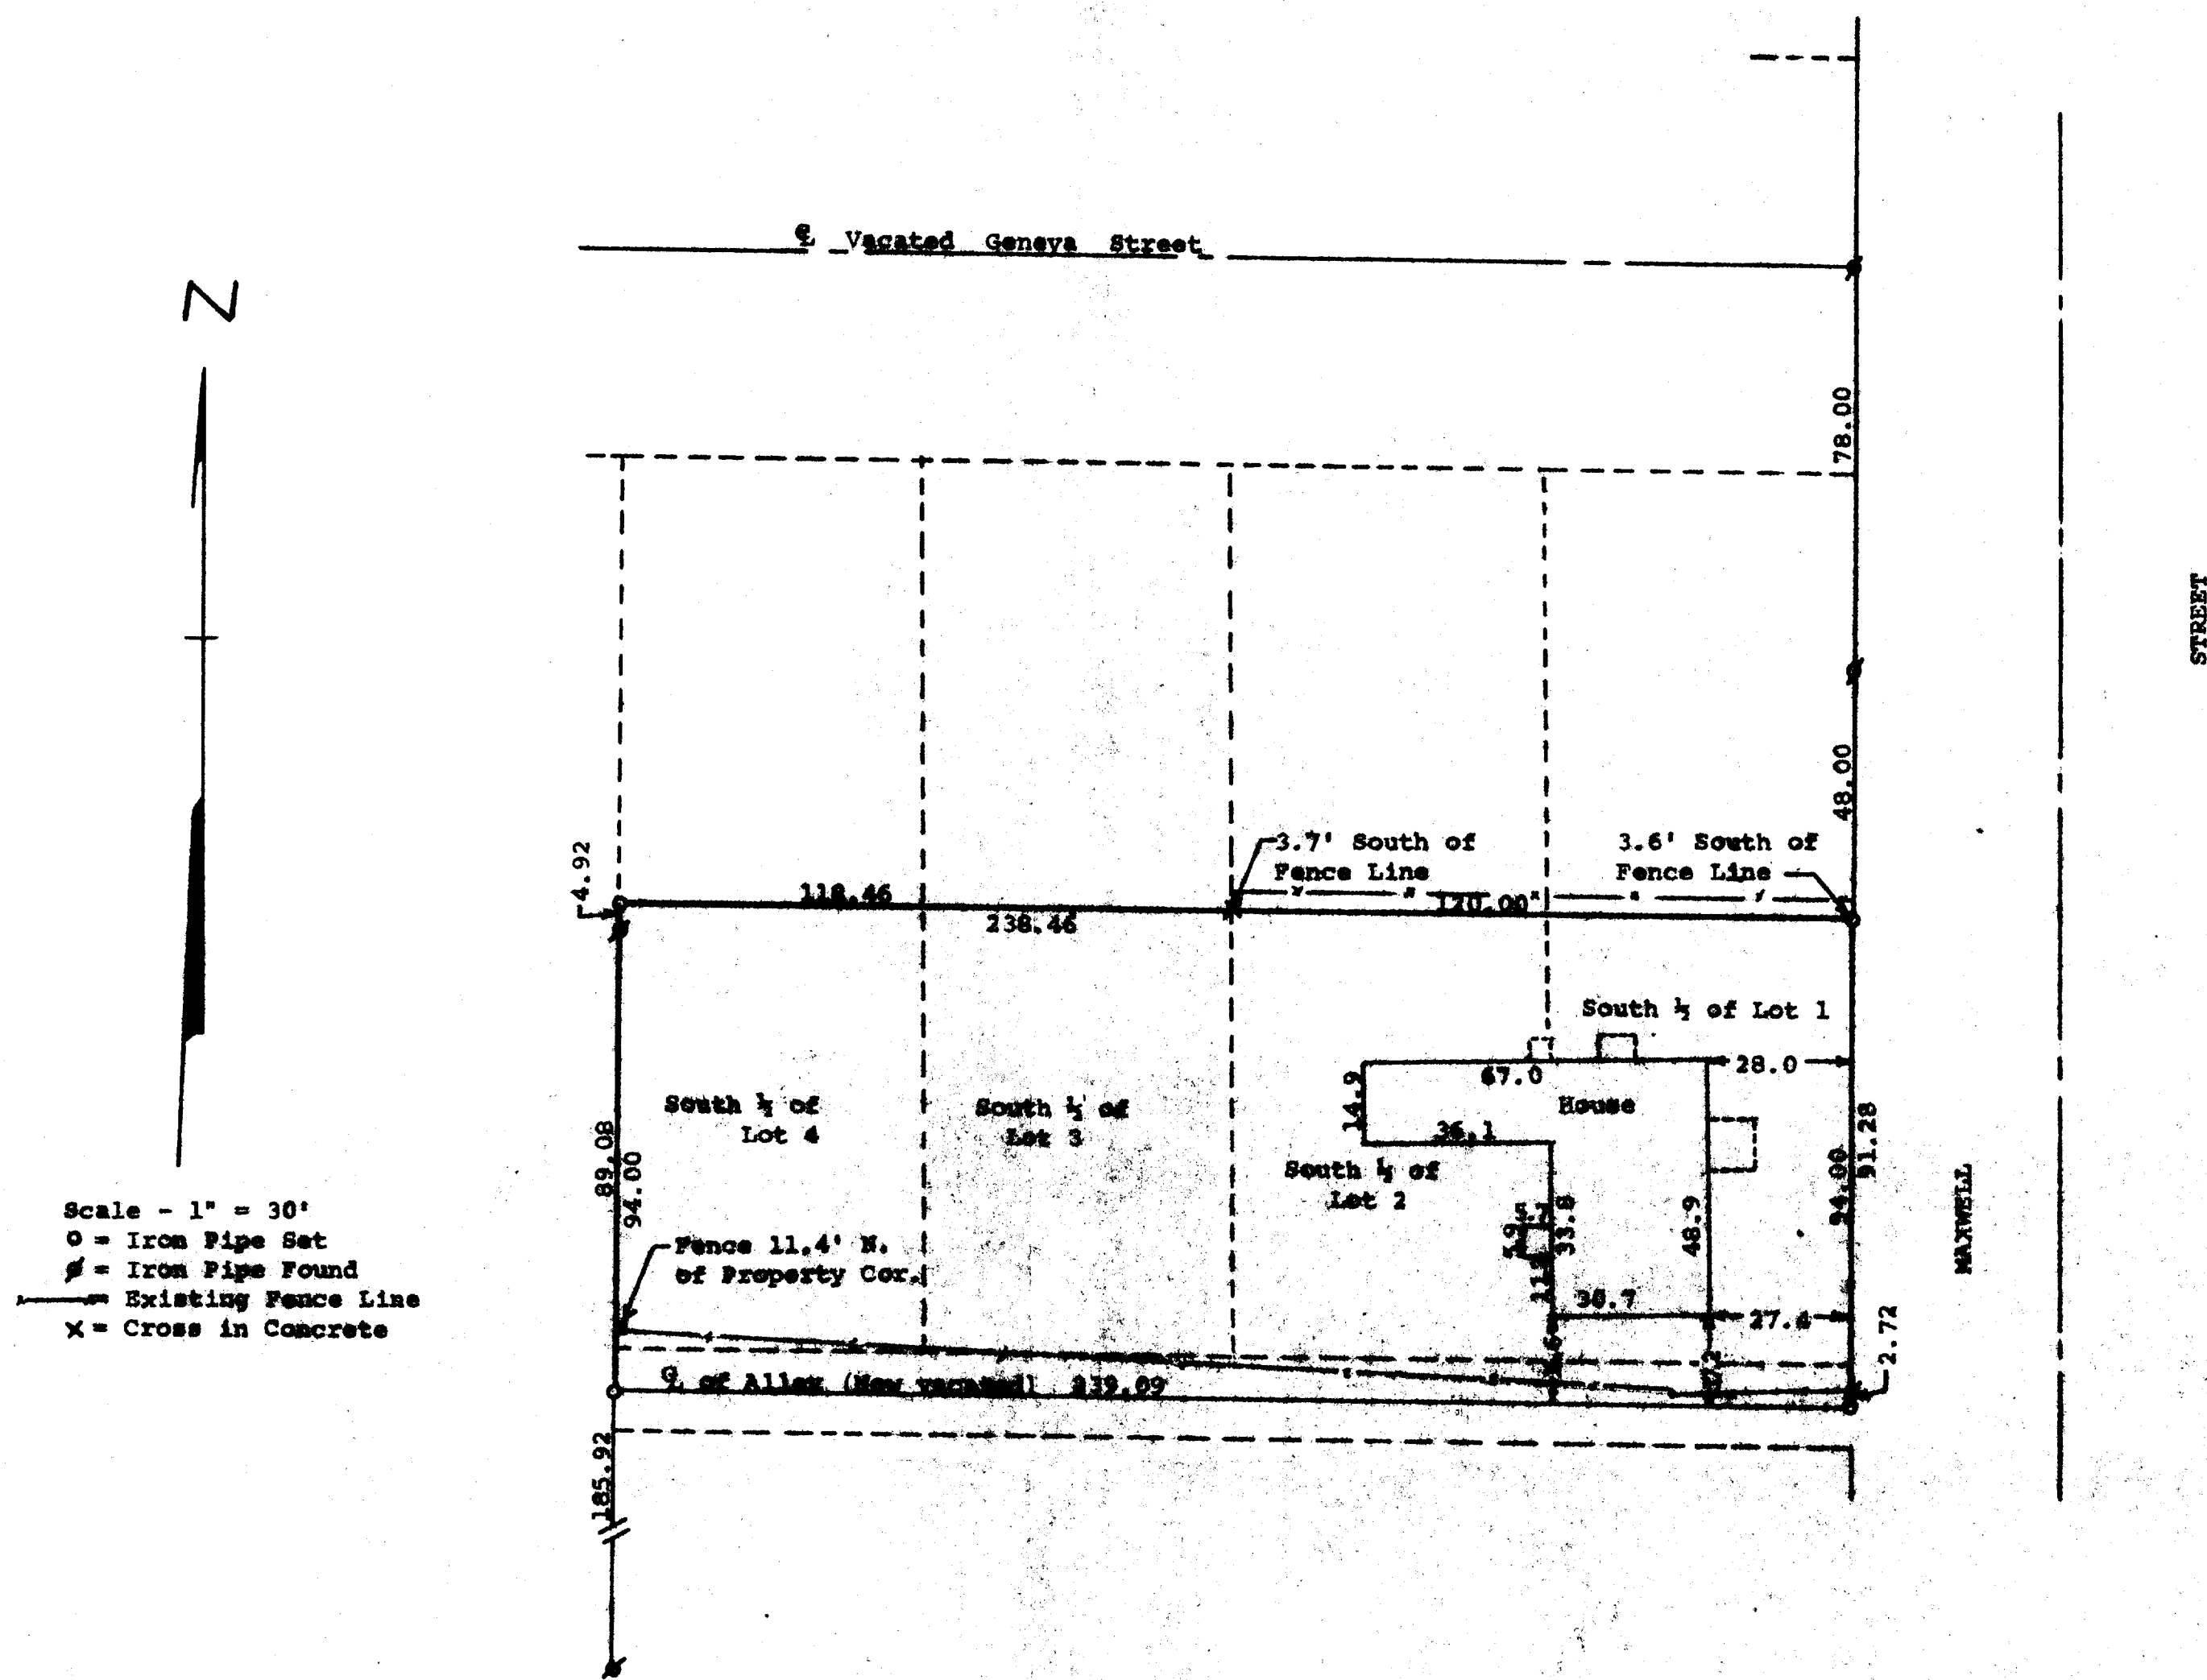

STATE OF WISCONSIN)
COUNTY OF WALWORTH) ss

I, George T. Dunham, Surveyor, certify that I have surveyed the property described as follows:

The South 1/4 of Lots 1, 2, 3, and 4, Block 22, Original Plat of the Village (Now City) of Lake Geneva, Walworth County, Wisconsin, together with all of the land lying north of the centerline of the Alley (Now Vacated) which was originally platted through said Block 22, lying between the southerly extension of the east line of said Lot 1 and the southerly extension of the west line of the aforesaid Lot 4.

and the above map is a true representation thereof and shows the size and location of the property, its exterior boundaries, the location and dimensions of all structures thereon, fences, apparent easements and roadways and visible encroachments, if any.

This survey is made for the exclusive use of the present owners of the property, and also those who purchase, mortgage, or guarantee the title thereto within one (1) year from date hereof, and as to them I warrant the accuracy of said survey and map.

December 13, 1976

George T. Dunham
George T. Dunham, Surveyor

