


HAROLD H. KOLB

**REGISTERED PROFESSIONAL LAND SURVEYOR
LAKE GENEVA, WISCONSIN**

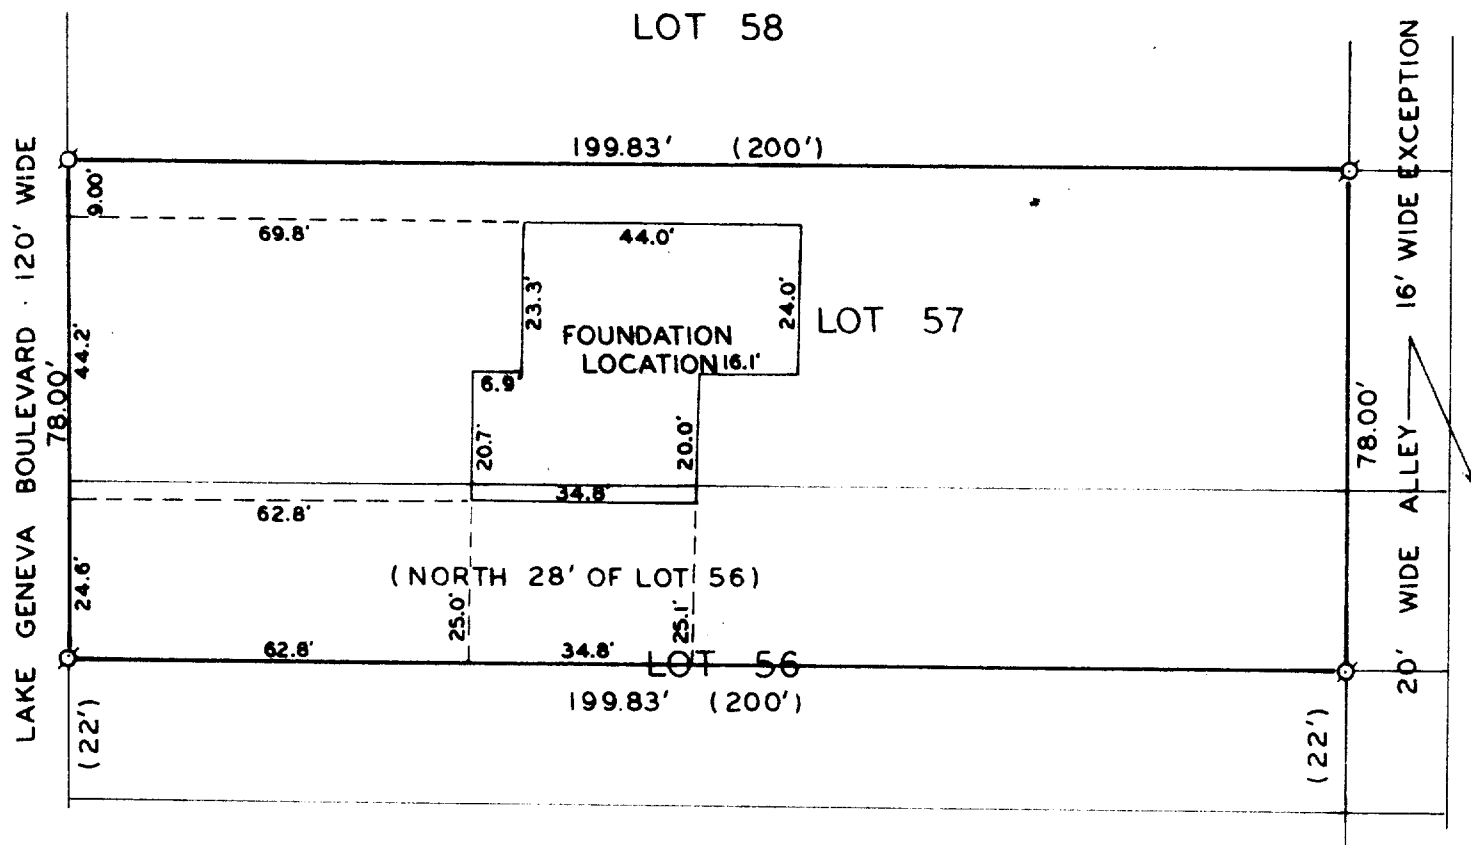

PLAT OF

A PROPOSED HOUSE LOCATION ON LOT 57 AND THE NORTH 28 FEET OF LOT 56, EXCEPT THE EAST 16 FEET THEREOF, BOULEVARD SUB-DIVISION, CITY OF LAKE GENEVA, WALWORTH COUNTY, WISCONSIN.

ORDERED BY: MIKE CARROLL

EUGENE BLONQUIST DO HEREBY CERTIFY THAT I HAVE SURVEYED THE PROPERTY HEREON DESCRIBED ACCORDING TO THE OFFICIAL RECORDS, AND THAT THE PLAT HEREON IS A CORRECT REPRESENTATION OF THE LOT LINES.

EUGENE BLONDSIST
WISCONSIN REGISTERED LAND SURVEYOR, S. 1279

DATE Sept. 27, 1916

REVISED DATE: NOVEMBER 15, 1976

7-577



SCALE · 1" = 30'

LEGEND

- ϕ — IRON PIPE FOUND
 ○ — IRON PIPE PLACED
 ● — CONCRETE MONUMENT
 X — SPIKE
 □ — WOOD STAKE

