


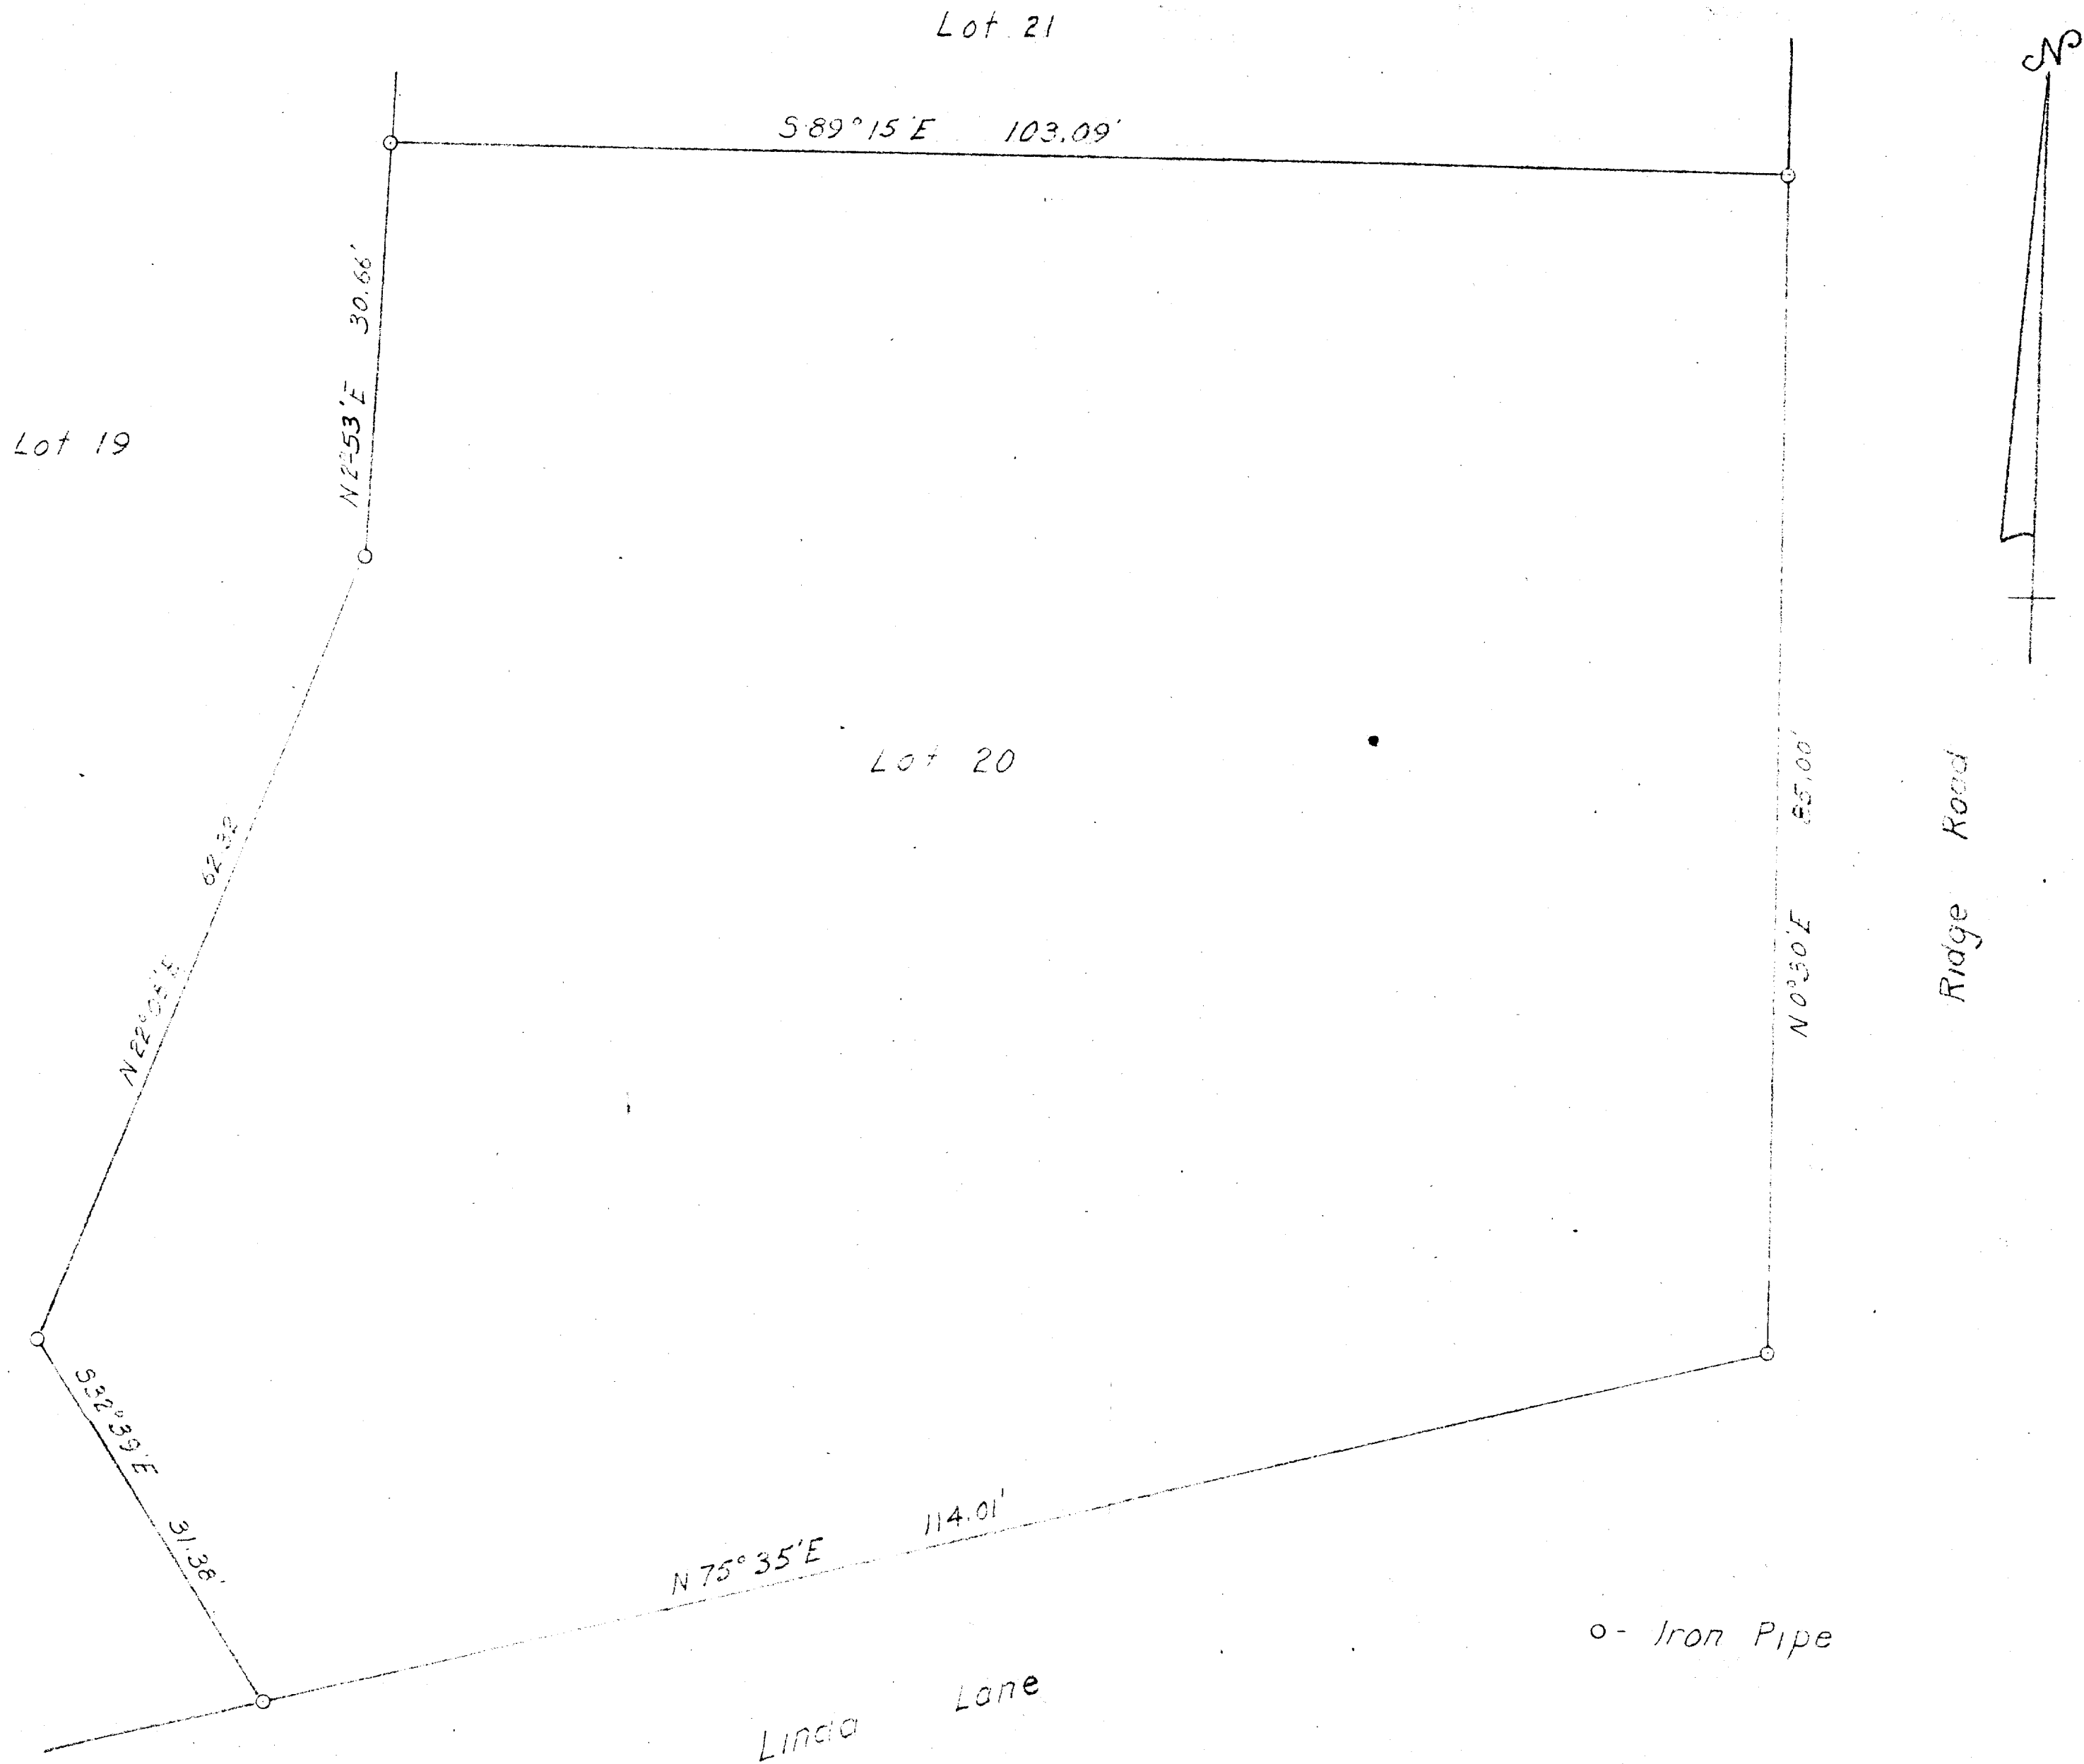

PLAT OF SURVEY
OF

Lot 20, Sturwood Addition, located in
the NE 1/4 of Section 35, T2N, R17E,
City of Lake Geneva, Walworth County,
Wisconsin

Lloyd L. Jensen
SURVEYOR

7-57J