


HAROLD H. KOLB

REGISTERED PROFESSIONAL LAND SURVEYOR
LAKE GENEVA, WISCONSIN

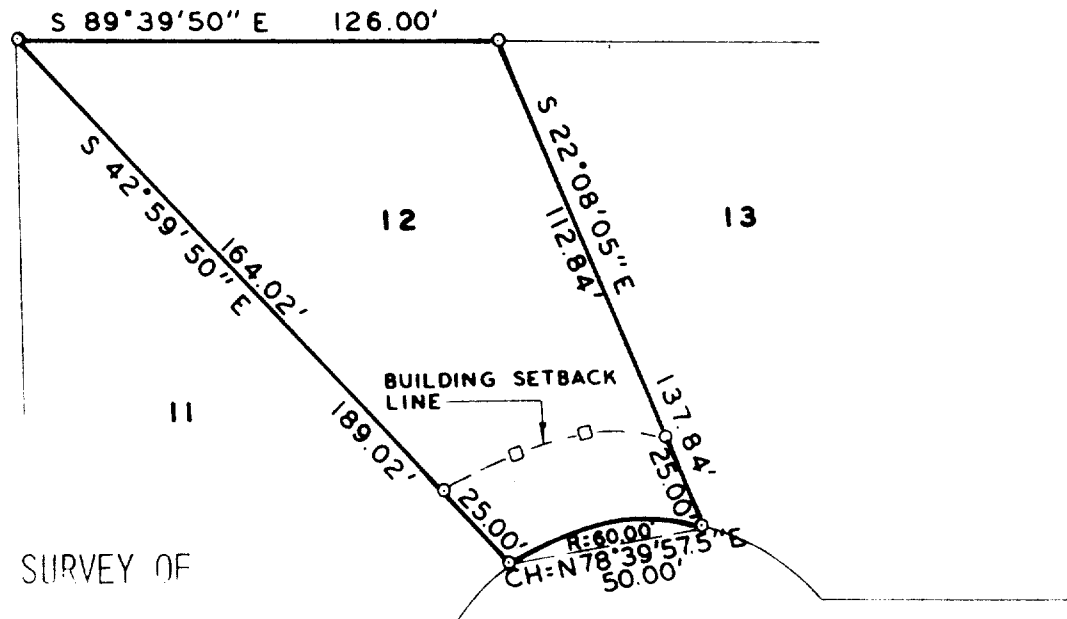

PLAT OF SURVEY OF

LOT 12, WESTGATE SUBDIVISION,
CITY OF LAKE GENEVA, WALWORTH
COUNTY, WISCONSIN.

MILLER COURT

60' WIDE

ORDERED BY: STEVE JUHAS

ACCURACY: DISTANCES $\pm$ 0.01'
ANGLES $\pm$ 05"

ERROR OF CLOSURE--LESS THAN ONE
PART IN 3000



SCALE - 1" = 50'

LEGEND

- φ — IRON PIPE FOUND
- — IRON PIPE PLACED
- — CONCRETE MONUMENT
- x — SPIKE
- — WOOD STAKE

I, HAROLD H. KOLB, DO HEREBY CERTIFY THAT I HAVE
SURVEYED THE PROPERTY HEREON DESCRIBED ACCORDING
TO THE OFFICIAL RECORDS, AND THAT THE PLAT HEREON
IS A CORRECT REPRESENTATION OF THE LOT LINES.

Harold H. Kolb

HAROLD H. KOLB
WISCONSIN REGISTERED LAND SURVEYOR, S-187

DATE Nov 15, 1974

7-585