


LOT 9

LOT 10

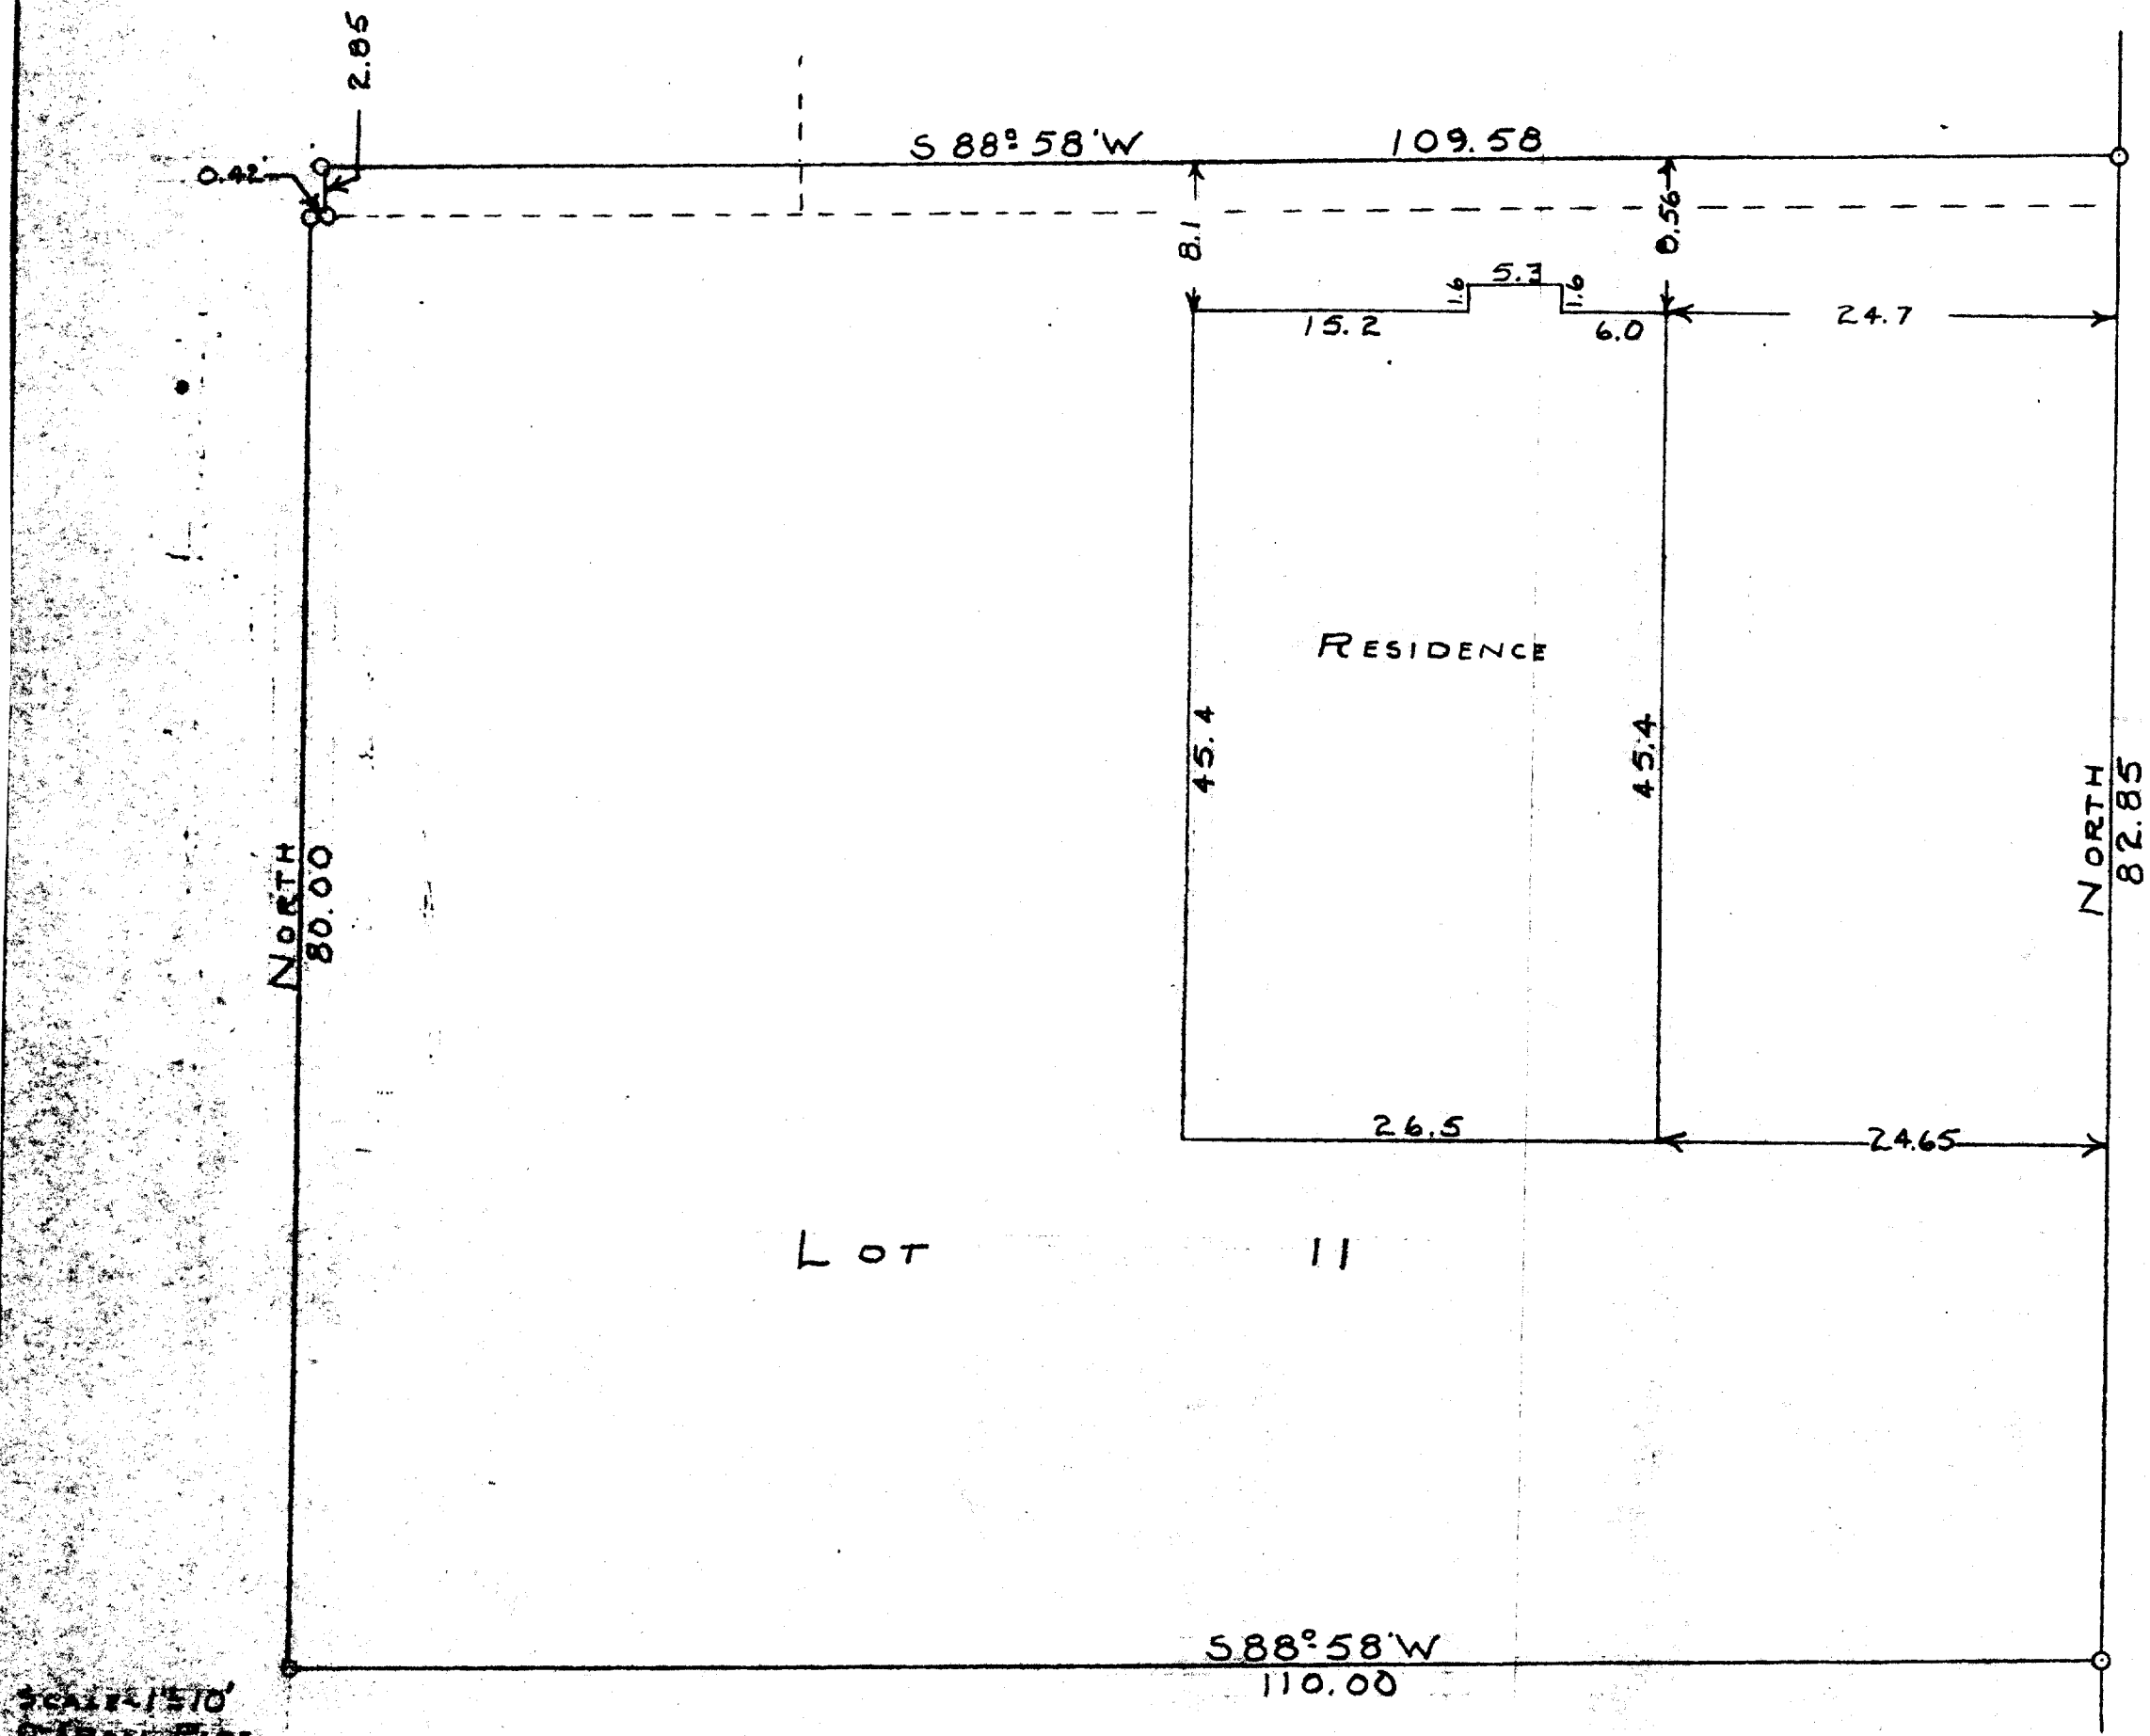

SCALE 1"=10'
IRON PIPE

STATE OF WISCONSIN)
WALWORTH COUNTY)SS

I, GEORGE T. DUNHAM, DO HEREBY CERTIFY THAT I HAVE SURVEYED THE PROPERTY DESCRIBED AS FOLLOWS:

LOT 11 AND THE SOUTH 2.85 FEET OF LOT 10 AND THE SOUTH 2.85 FEET OF THE EAST 36.58 FEET OF LOT 9, BLOCK 1, MCKENNA ADDITION, CITY OF LAKE GENEA, WALWORTH COUNTY, WISCONSIN. AND THAT THE PLAT SHOWN ABOVE IS A CORRECT REPRESENTATION OF THE PROPERTY LINES AND OF THE IMPROVEMENTS LOCATED THEREON OCT. 9, 1957

MC-11

George T. Dunham
GEORGE T. DUNHAM, SURVEYOR
DELAVER WISCONSIN

7-59