



HAROLD H. KOLB

REGISTERED PROFESSIONAL LAND SURVEYOR
LAKE GENEVA, WISCONSIN

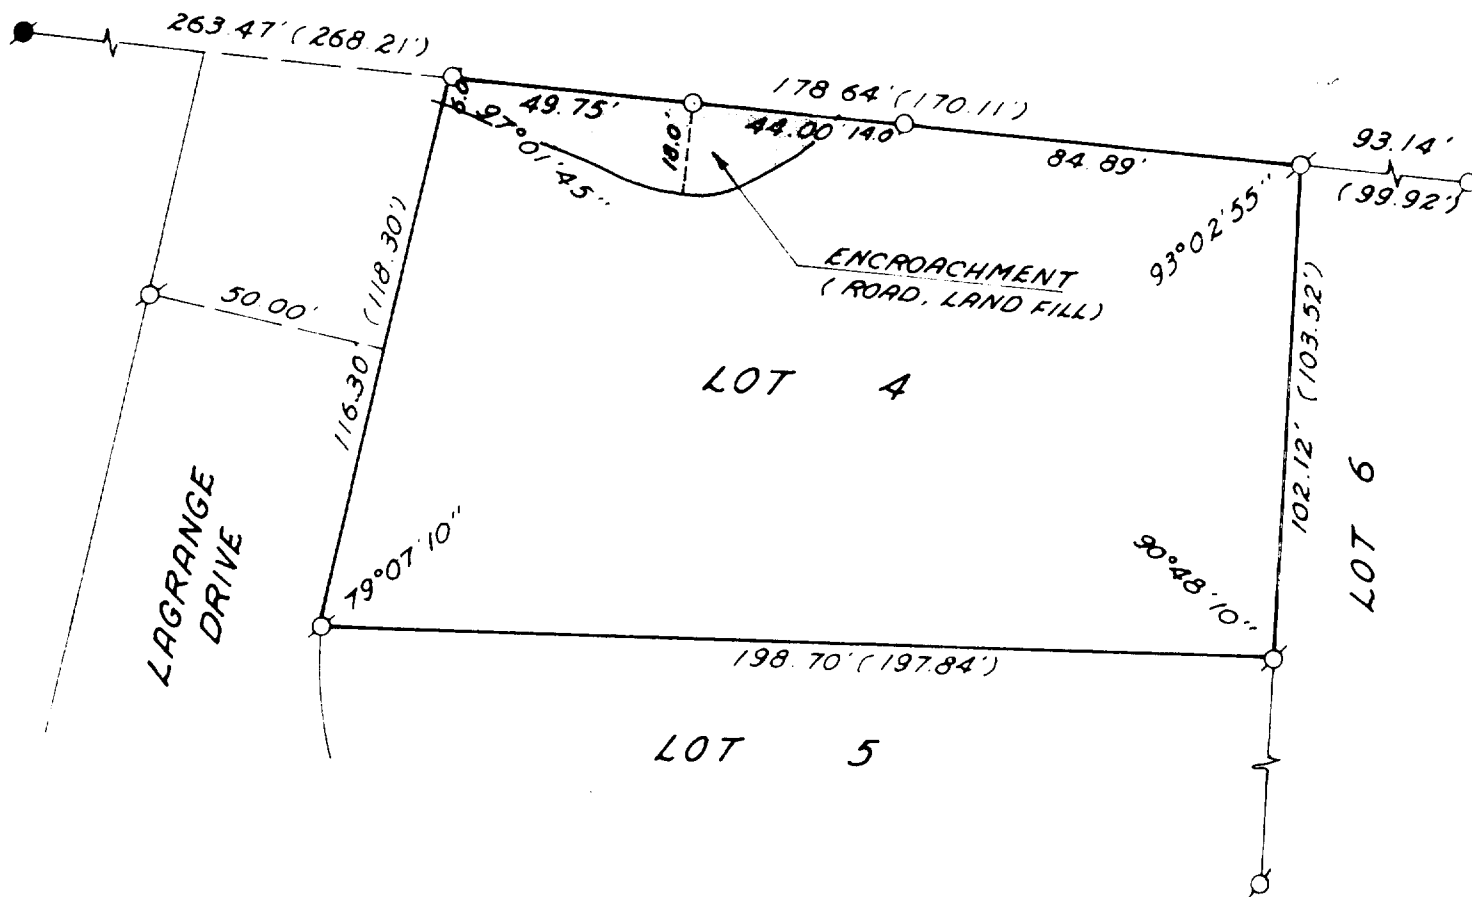

PLAT OF SURVEY OF

LOT 4, LAKE GENEVA EAST SHORE
ESTATES, LAKE GENEVA, WISCONSIN

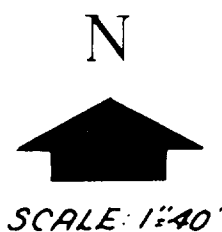

LEGEND

- — IRON PIPE PLACED, 1" x 24" 1.13 LB LIN FT
- — CONCRETE MONUMENT, 5" DIA. x 30"
- () — DATE, A.D.

HAROLD H. KOLB
WISCONSIN REGISTERED LAND SURVEYOR, S-187
DATE 4/1/71