


CENTER

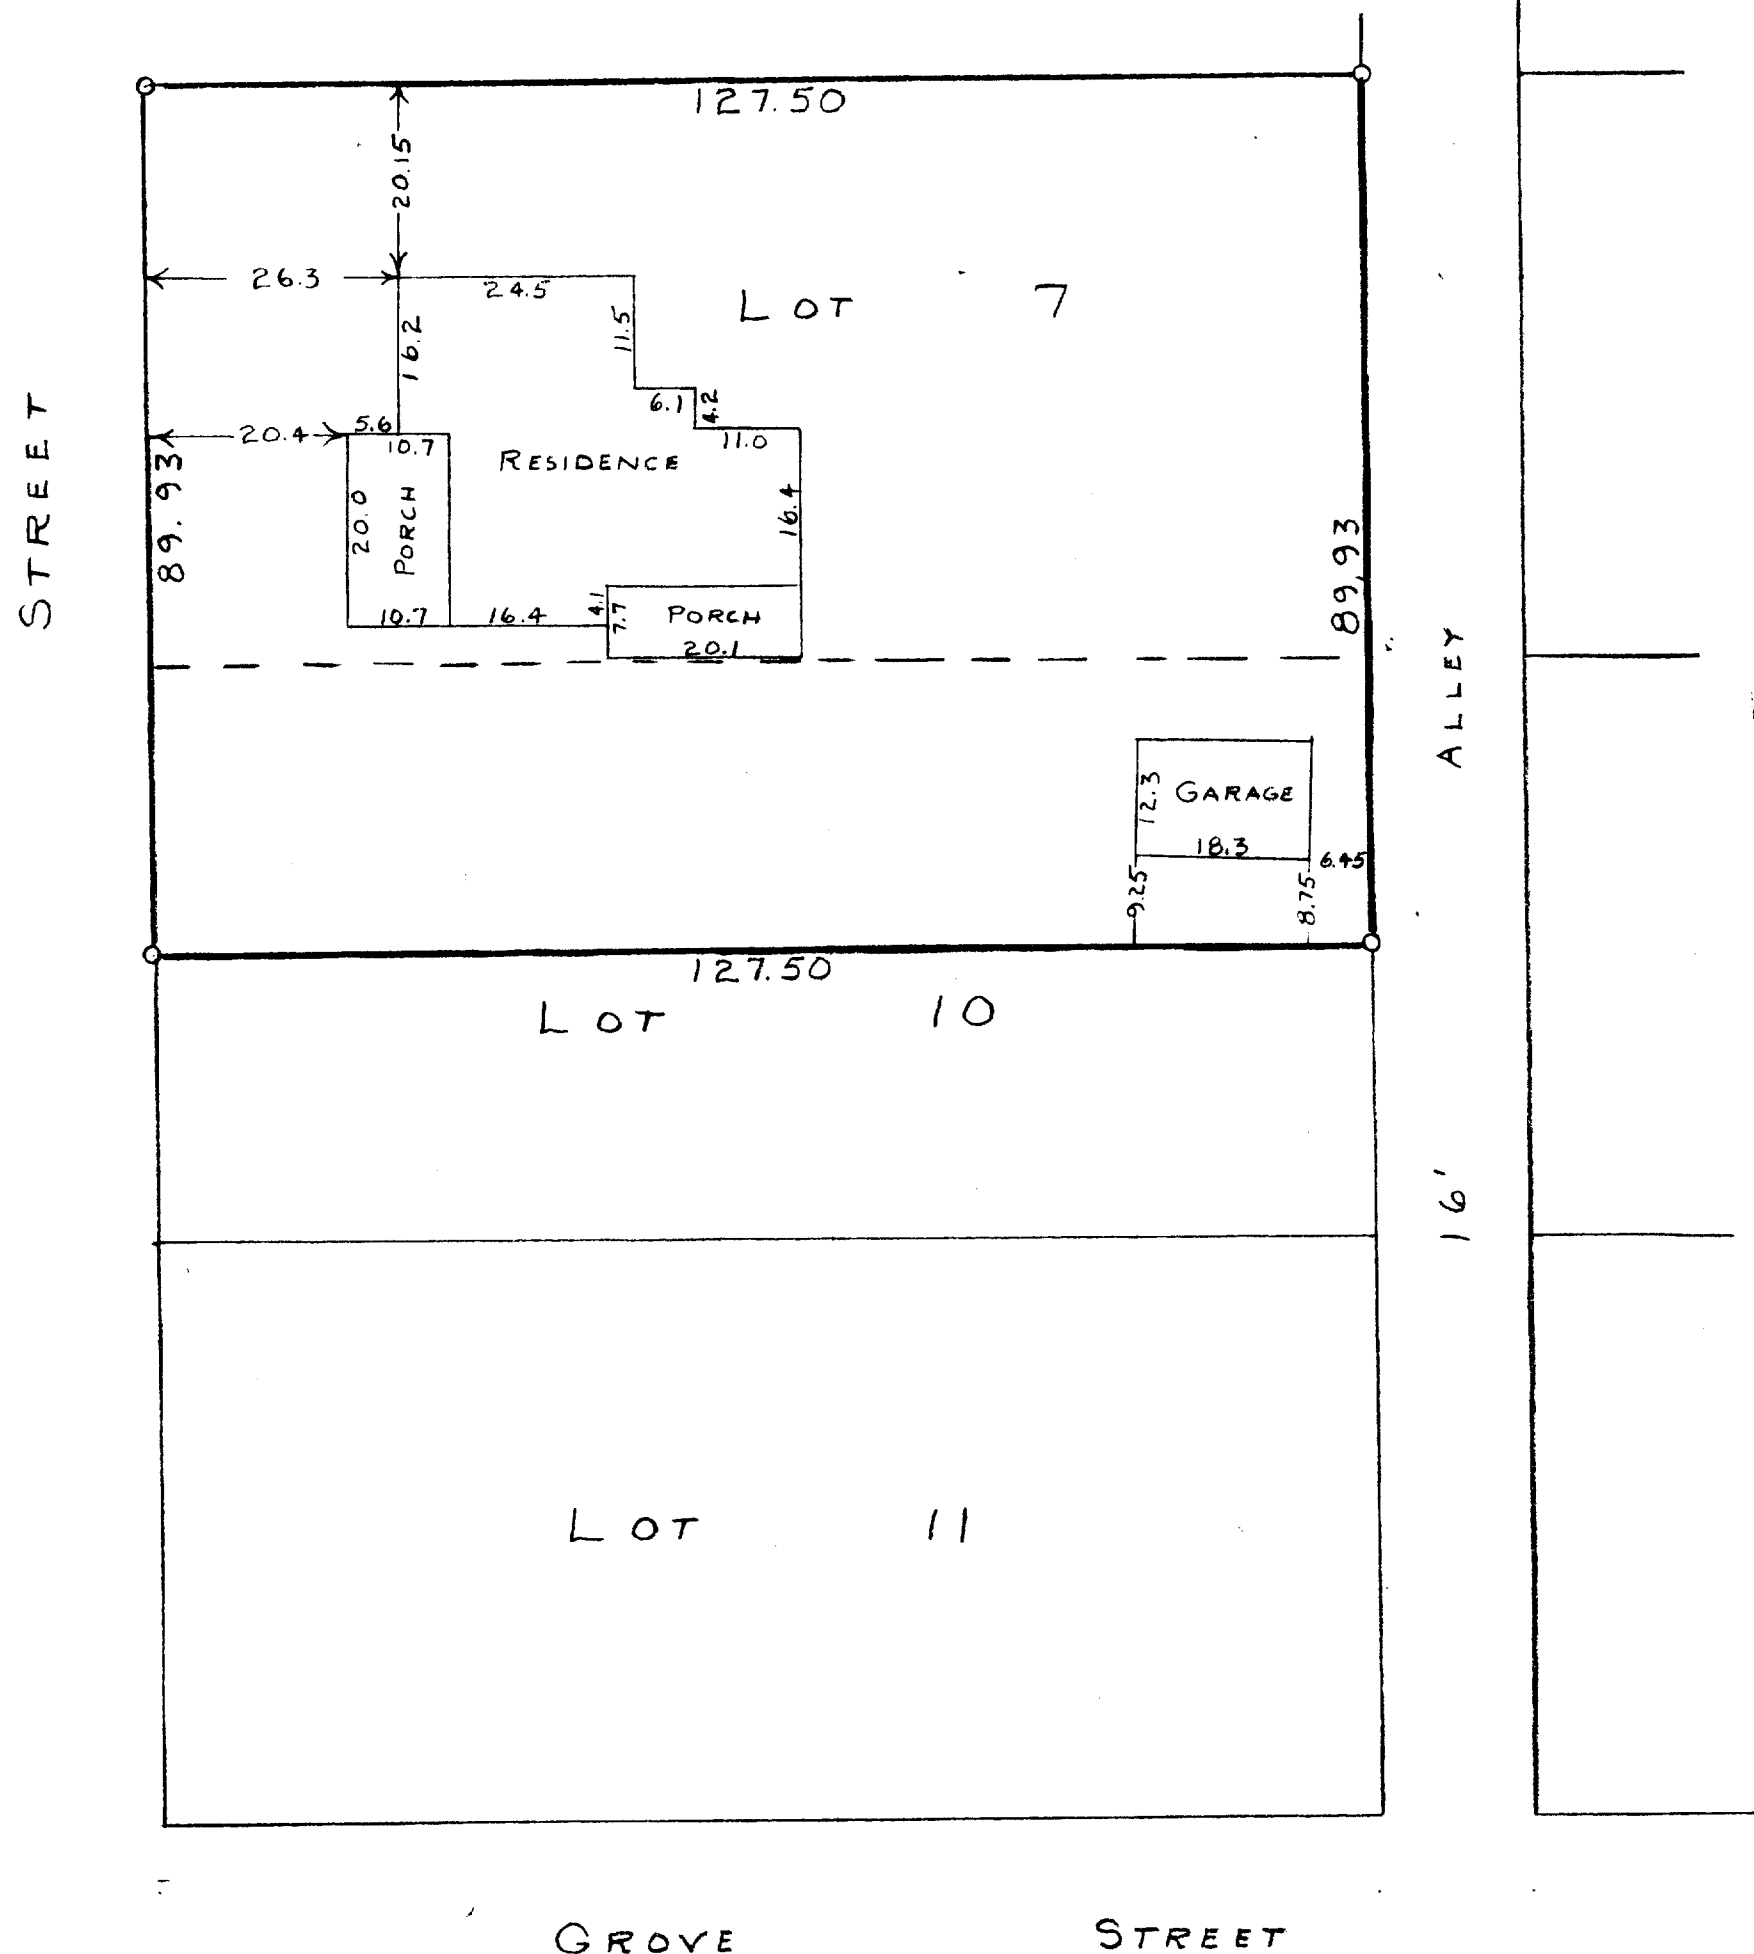

N

SCALE - 1" = 20'

0 = IRON PIPE

STATE OF WISCONSIN) ss
COUNTY OF WALWORTH)

I, GEORGE T. DUNHAM, DO HEREBY CERTIFY THAT I HAVE SURVEYED
THE PROPERTY DESCRIBED AS FOLLOWS:

LOT 7 AND THE NORTH 1/2 OF LOT 10 BLOCK 6 OF GENEVA
LAKE CRAWFORD MANUFACTURING COMPANY'S ADDITION, CITY
OF LAKE GENEVA, WALWORTH COUNTY, WISCONSIN.

AND THAT THE PLAT SHOWN ABOVE IS A CORRECT REPRESENTATION OF
THE PROPERTY LINES
NOV. 16, 1955

GC-14

GC-42A (part of)

George T. Dunham
GEORGE T. DUNHAM, SURVEYOR
DELAVER, WISCONSIN

7-6