


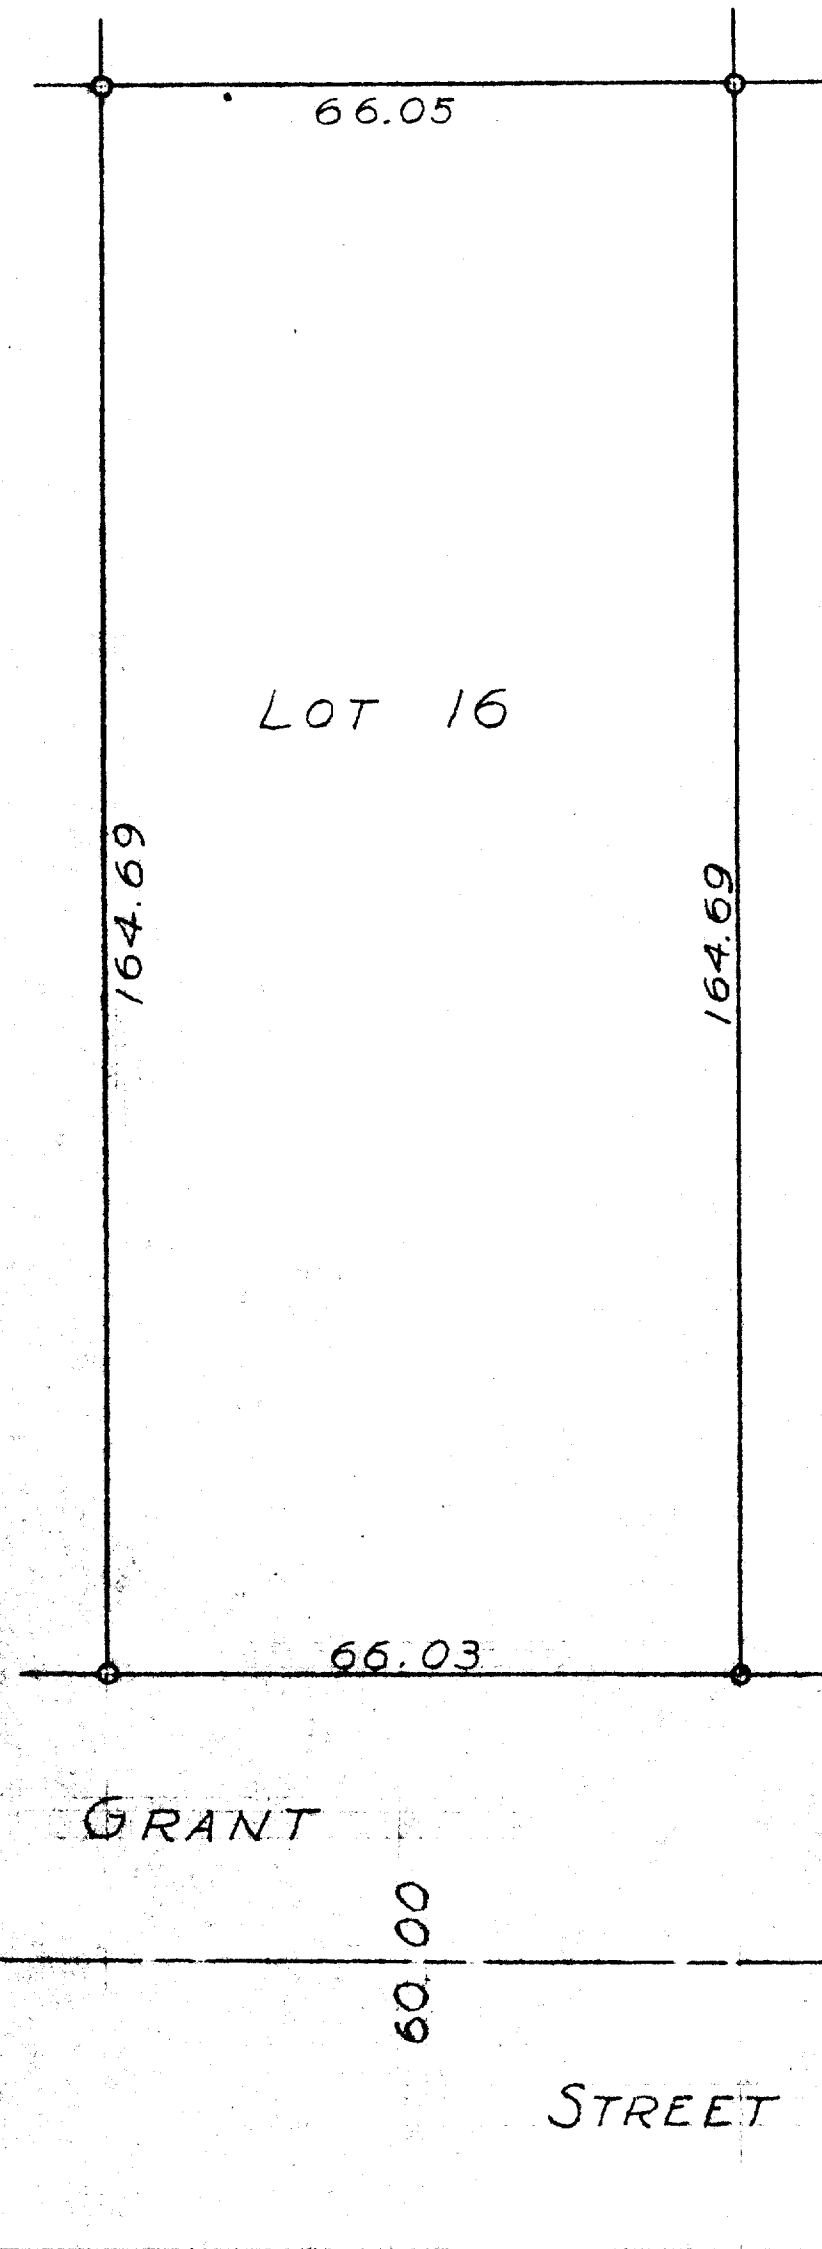

ZWH PB

N

SCALE ~ 1" = 20'
0 ~ IRON PIPE

STATE OF WISCONSIN } S.S.
COUNTY OF WALWORTH }

I, GEORGE T. DUNHAM, DO HEREBY CERTIFY THAT I
HAVE SURVEYED THE PROPERTY DESCRIBED AS FOLLOWS:
LOT 16, BLOCK 2, WHEELER'S ADDITION
TO THE VILLAGE (NOW CITY) OF LAKE
GENEVA, WALWORTH COUNTY, WISCONSIN.

AND THAT THE PLAT SHOWN ABOVE IS A CORRECT REP-
RESENTATION OF THE PROPERTY LINES AND IMPROVEMENTS
LOCATED THEREON.
SEPTEMBER 16, 1957

George T. Dunham
GEORGE T. DUNHAM, SURVEYOR
DELAVER, WISCONSIN 7-62