

HAROLD H. KOLB


REGISTERED PROFESSIONAL LAND SURVEYOR
LAKE GENEVA, WISCONSIN

GENEVA STREET

80' WIDE

80' WIDE

CENTER STREET

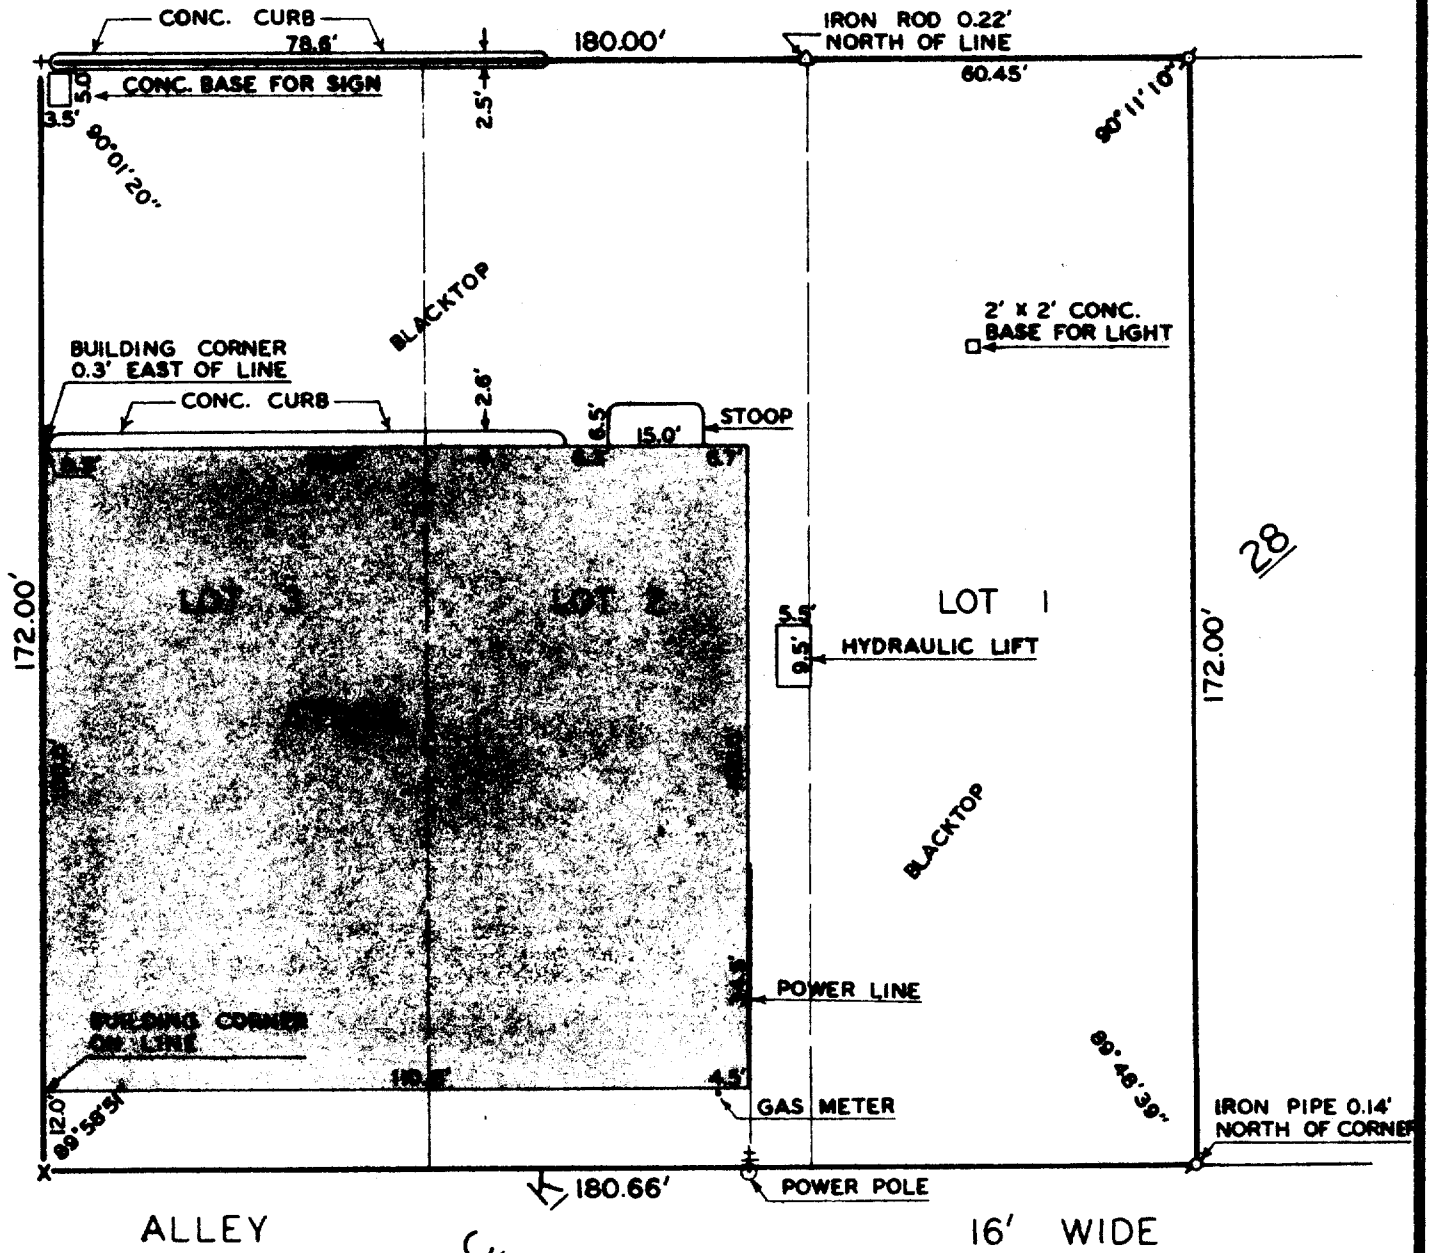

PLAT OF SURVEY OF


LOTS 1, 2 AND 3, BLOCK 28 OF
THE ORIGINAL PLAT OF THE CITY
OF LAKE GENEVA, WALWORTH
COUNTY, WISCONSIN.

ORDERED BY: NATIONAL TEA CO.
9701 WEST HIGGINS
ROSEMONT, IL 60018



SCALE: 1" = 30'
LEGEND

- φ — IRON PIPE FOUND
- O — IRON PIPE PLACED
- Δ — IRON ROD FOUND
- x — RAILROAD SPIKE PLACED
- + — CUT-CROSS

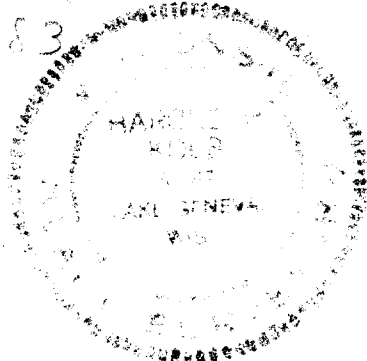

I, HAROLD H. KOLB, DO HEREBY CERTIFY THAT I HAVE
SURVEYED THE PROPERTY HEREON DESCRIBED ACCORDING
TO THE OFFICIAL RECORDS, AND THAT THE PLAT HEREON
IS A CORRECT REPRESENTATION OF THE LOT LINES.

Harold H. Kolb
HAROLD H. KOLB
WISCONSIN REGISTERED LAND SURVEYOR, S-187
DATE AUG 25, 1977

7-629