


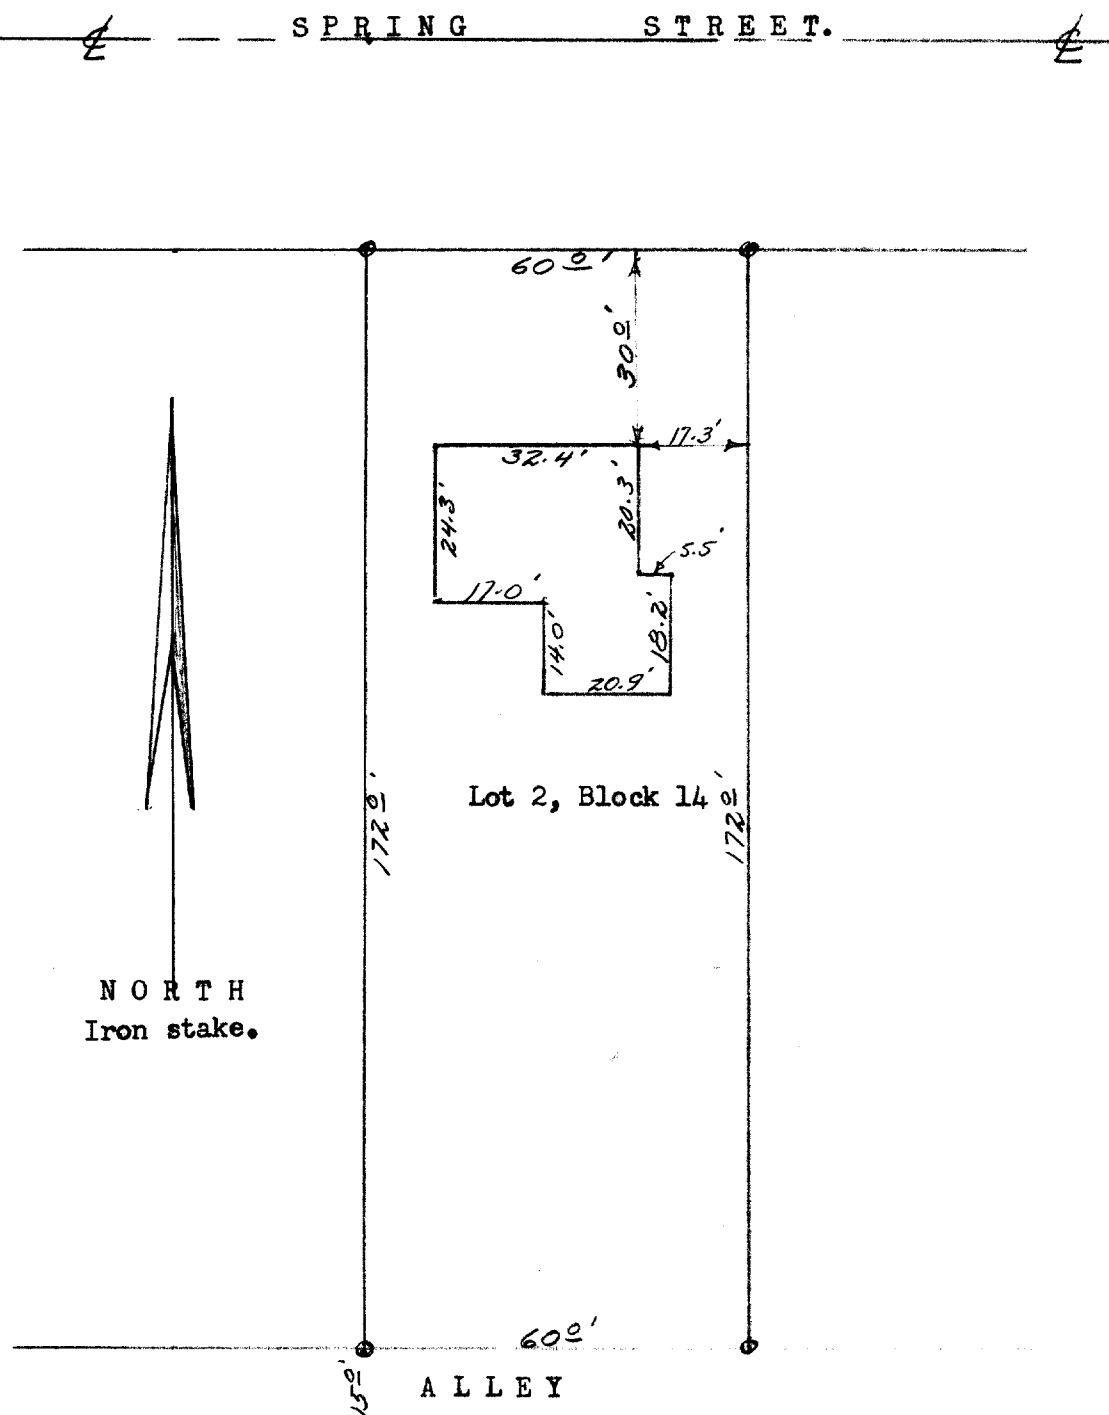

DESCRIPTION: Lot 2 Block 14 in Geneva Lake Crawford Manufacturing Company's Addition to the Village of Geneva, now City of Lake Geneva, Walworth County, Wisconsin.

CERTIFICATE: I hereby certify that I have surveyed the above mentioned property and that the hereon portrayed is an accurate survey and a true representation thereof and correctly shows the exterior boundary lines and the location of the buildings and the other improvements thereof.

Dated January 24th 1967.

James E. Blagi RLS 972
Elkhorn, Wisconsin.

JAMES E.

8-25-67

ANALYST

WIS.