


HAROLD H. KOLB

REGISTERED PROFESSIONAL LAND SURVEYOR
LAKE GENEVA, WISCONSIN

LOGAN STREET

60' WIDE

CL

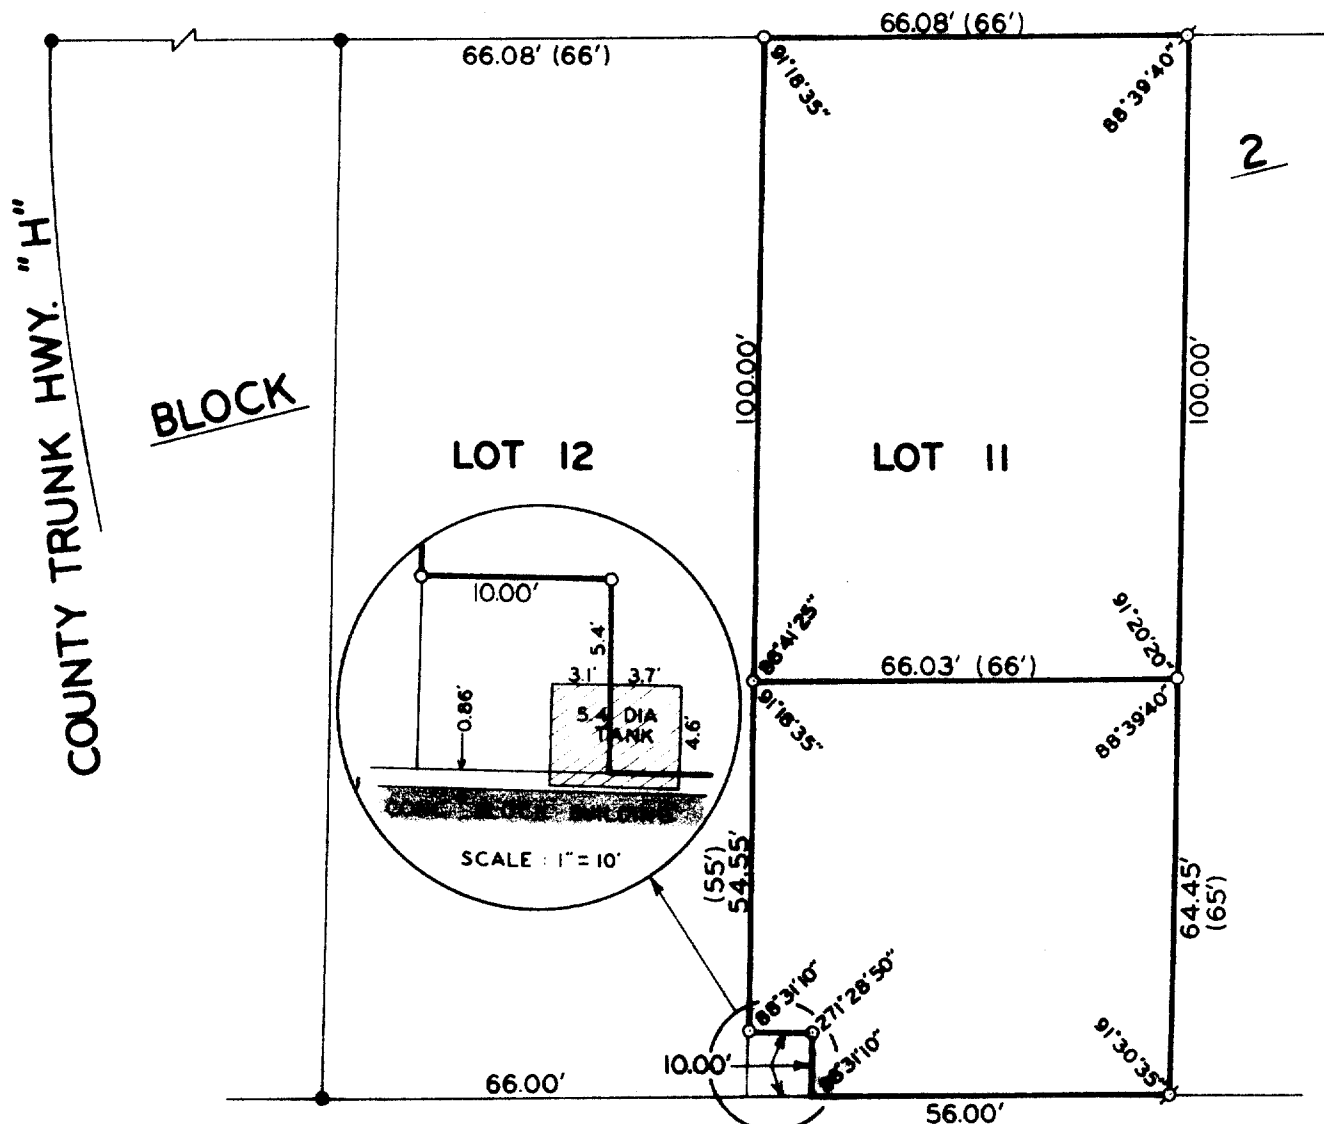

PLAT OF SURVEY OF

THE NORTH 100.00 FEET OF LOT 11, BLOCK 2,
WHEELERS ADDITION TO THE CITY OF LAKE GENEVA,
WALWORTH COUNTY, WISCONSIN.

LOT 11, EXCEPT THE NORTH 100.00 FEET OF LOT 11,
ALSO EXCEPTING A 10.00 FOOT BY 10.00 FOOT PARCEL
IN THE SOUTHWEST CORNER OF LOT 11, BLOCK 2,
WHEELERS ADDITION TO THE CITY OF LAKE GENEVA,
WALWORTH COUNTY, WISCONSIN.

ORDERED BY: LEO POTTER, JR.

ZWH-70



SCALE: 1" = 30'



LEGEND

- — IRON PIPE PLACED, 1" x 24" 1.13 LB./LIN. FT.
- — CONCRETE MONUMENT, 5" DIA. x 30"
- ⊗ — IRON PIPE FOUND () — AS PLATTED

I, HAROLD H. KOLB, DO HEREBY CERTIFY THAT I HAVE
SURVEYED THE PROPERTY HEREON DESCRIBED ACCORDING
TO THE OFFICIAL RECORDS, AND THAT THE PLAT HEREON
IS A CORRECT REPRESENTATION OF THE LOT LINES.

Harold H. Kolb

HAROLD H. KOLB
WISCONSIN REGISTERED LAND SURVEYOR, S-187

DATE Dec. 8, 1977

7-630