


PLAT OF SURVEY of Lots 31 and 32 of Block 31, Lake Geneva Manor  
 Subdivision, City of Lake Geneva, Walworth County, Wisconsin.

OWNER: L.J. Quade  
 SURVEYED FOR: H.F. Worth, Jr. Elkhorn, Wis.

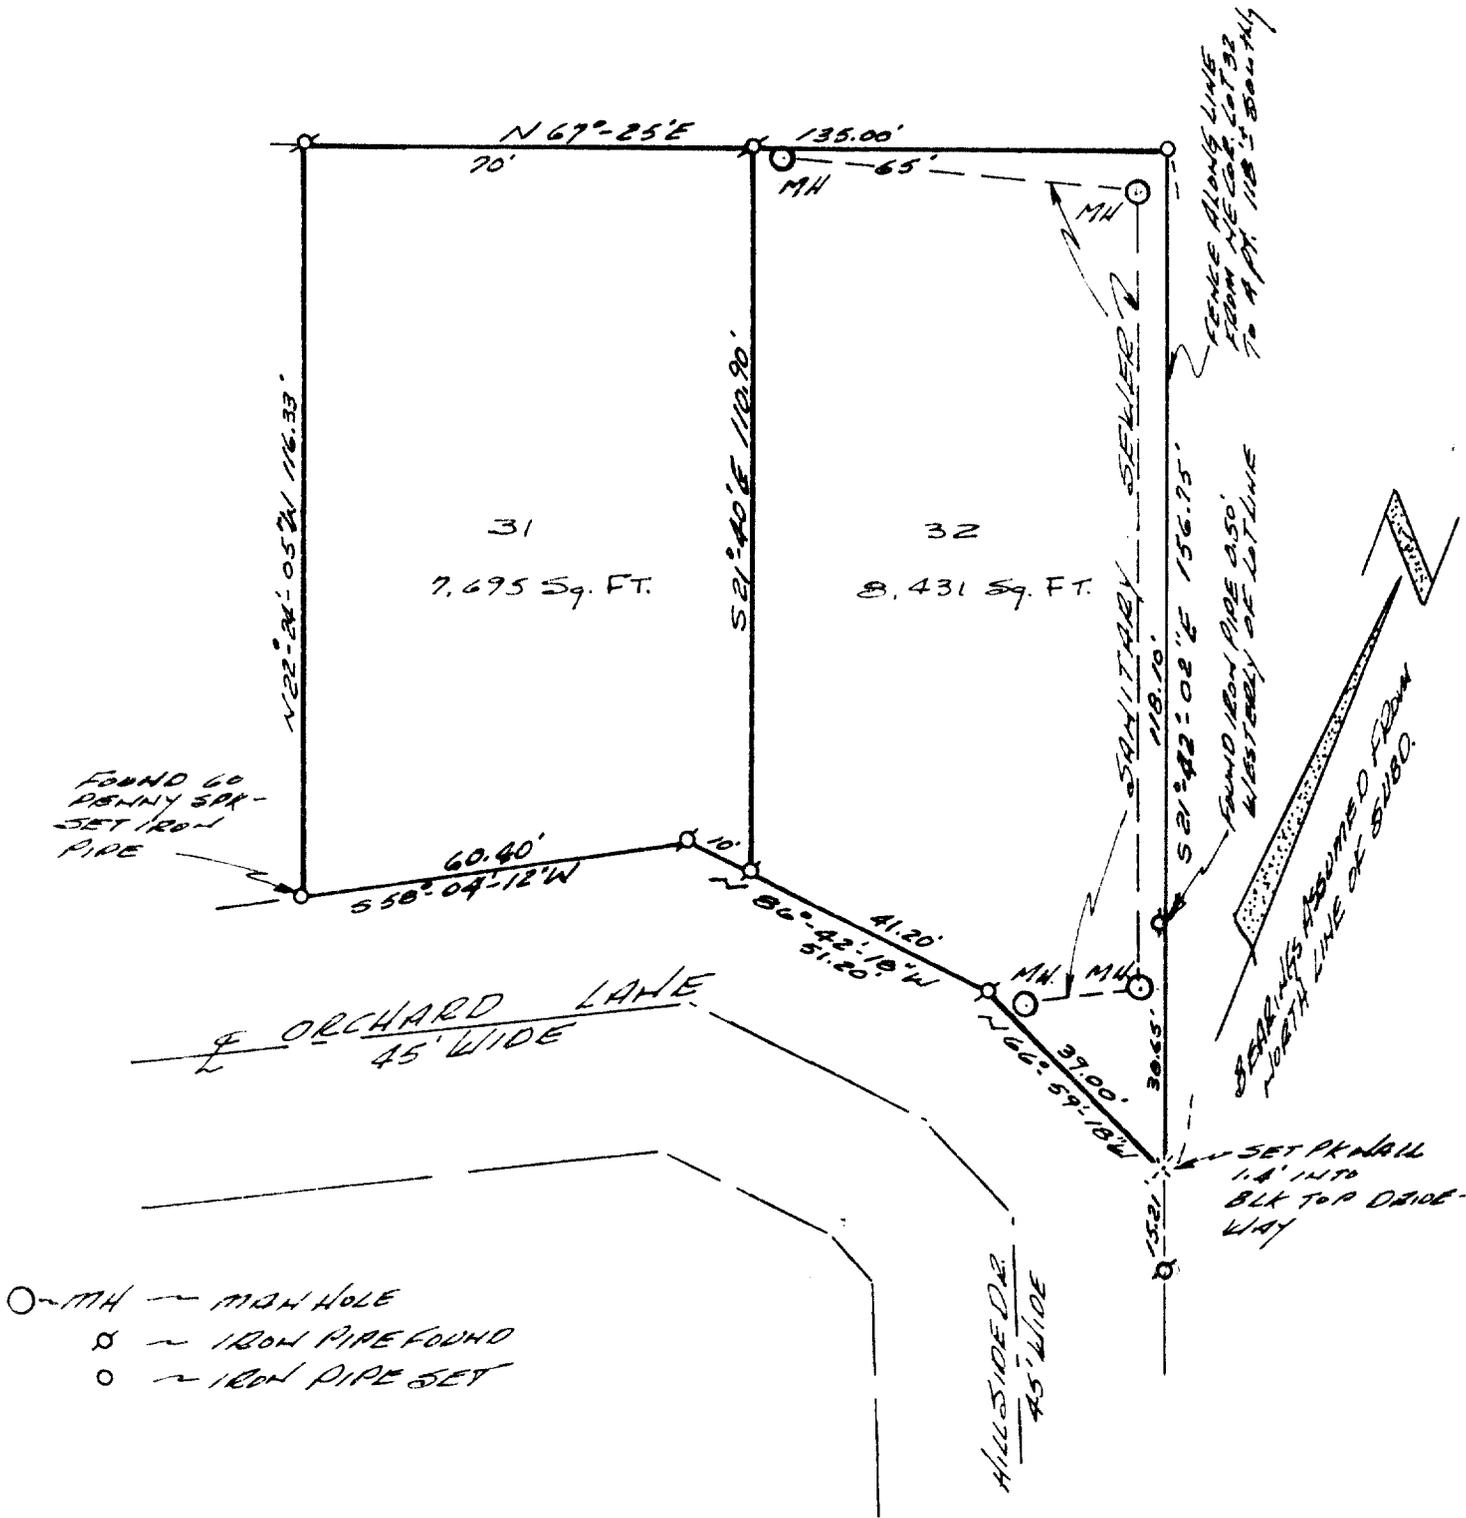

I certify that the above described land has been surveyed under my direction and that the plat shown hereon is an accurate survey and a true representation thereof and correctly shows the boundary lines of said property and all divisions thereof.

Jan. 20, 1978

*Lloyd S. Jensen*  
 Lloyd S. Jensen S-211  
 Elkhorn, Wisconsin

