



PLAT OF SURVEY OF: Lot 71 except the East 16 feet thereof of Boulevard
Subdivision in the City of Lake Geneva, Walworth County, Wisconsin
Address: 1085 Lake Geneva Boulevard, Lake Geneva, Wis.
Work ordered by: Carl Reeves for Vern Twist & Associates, Lake Geneva, Wis.

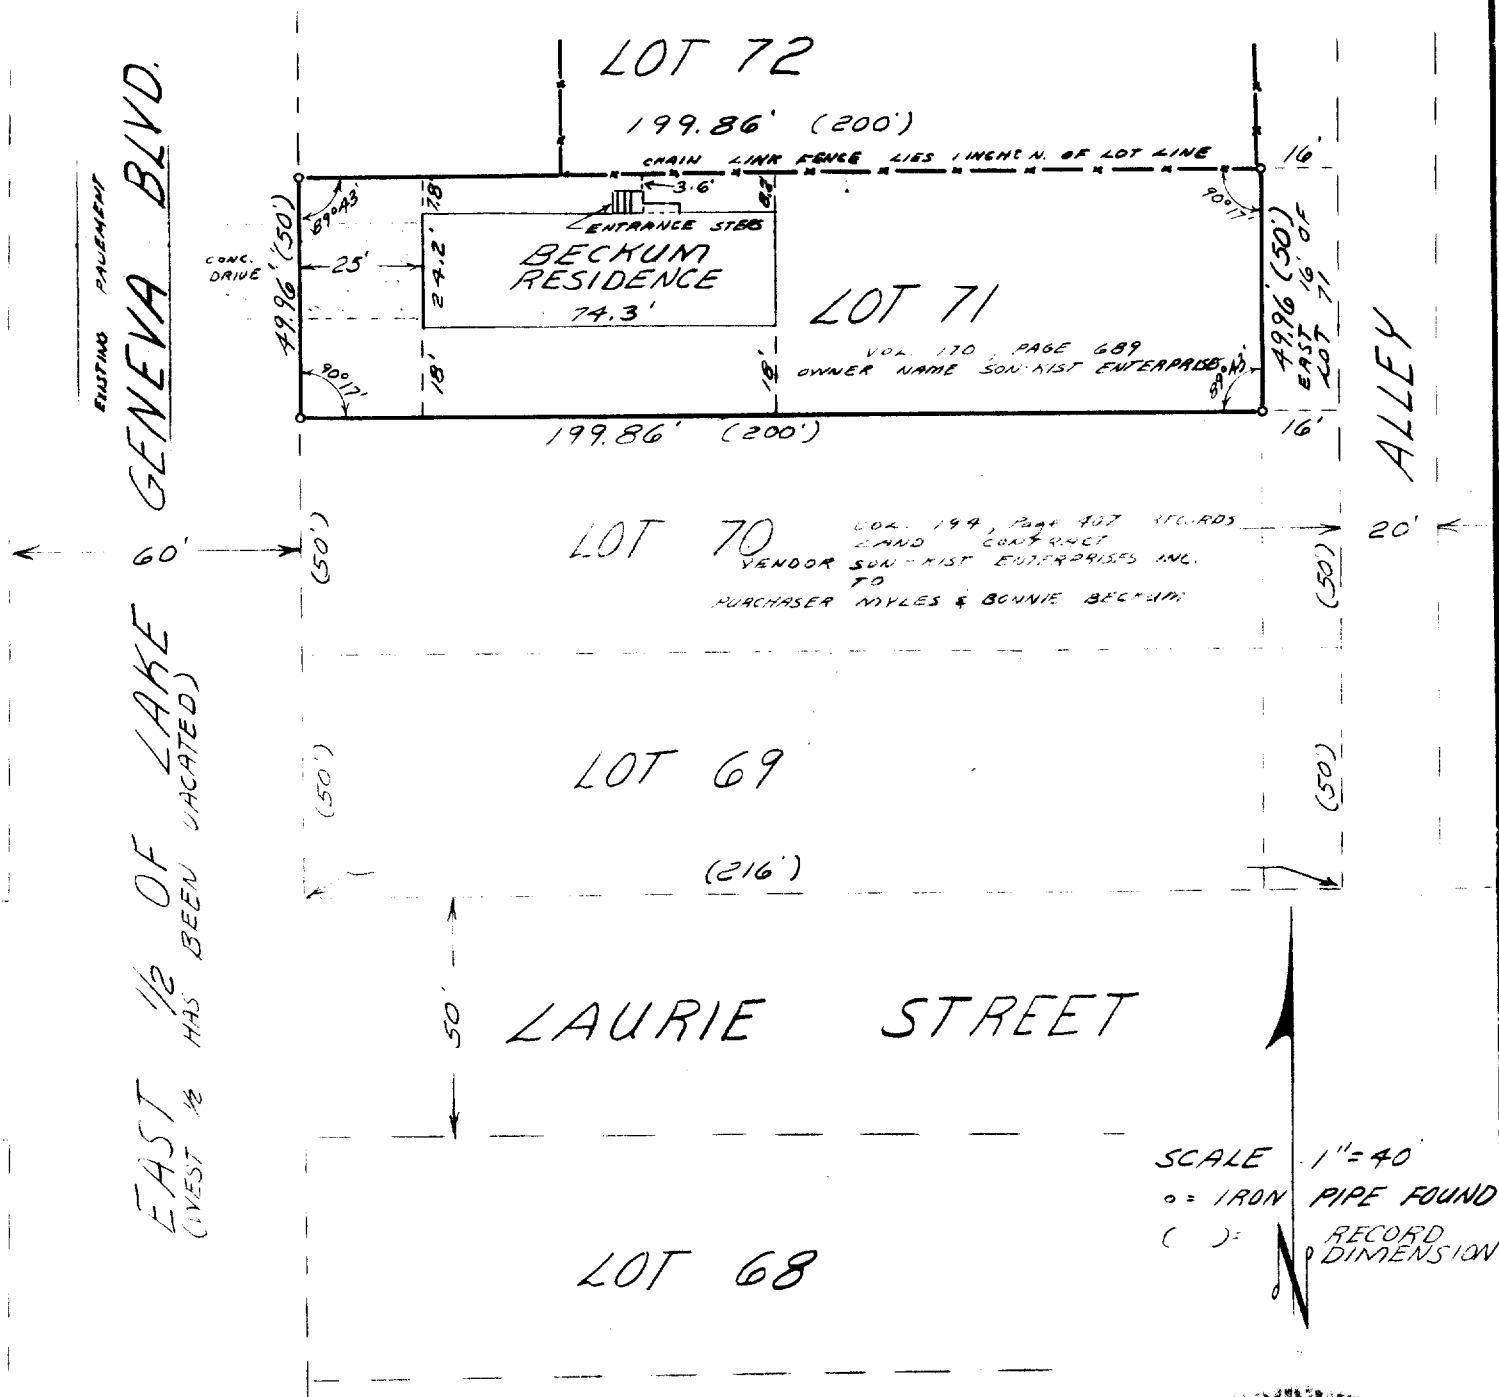

I hereby certify that I have surveyed the above described property and that this map is a true representation thereof and shows the size and location of the property, its exterior boundary, the location of all visible structures thereon, fences, apparent easements and visible encroachments to the best of my knowledge and belief.

Robert A. Farris

Robert A. Farris s-1293
Dated 22 Feb 1978

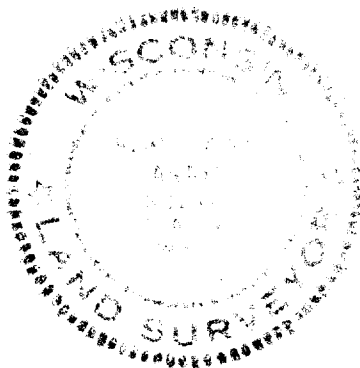

DRWG. NO. 1312

ZBL-41A

7-633