


**HAROLD H. KOLB**

**REGISTERED PROFESSIONAL LAND SURVEYOR  
LAKE GENEVA, WISCONSIN**

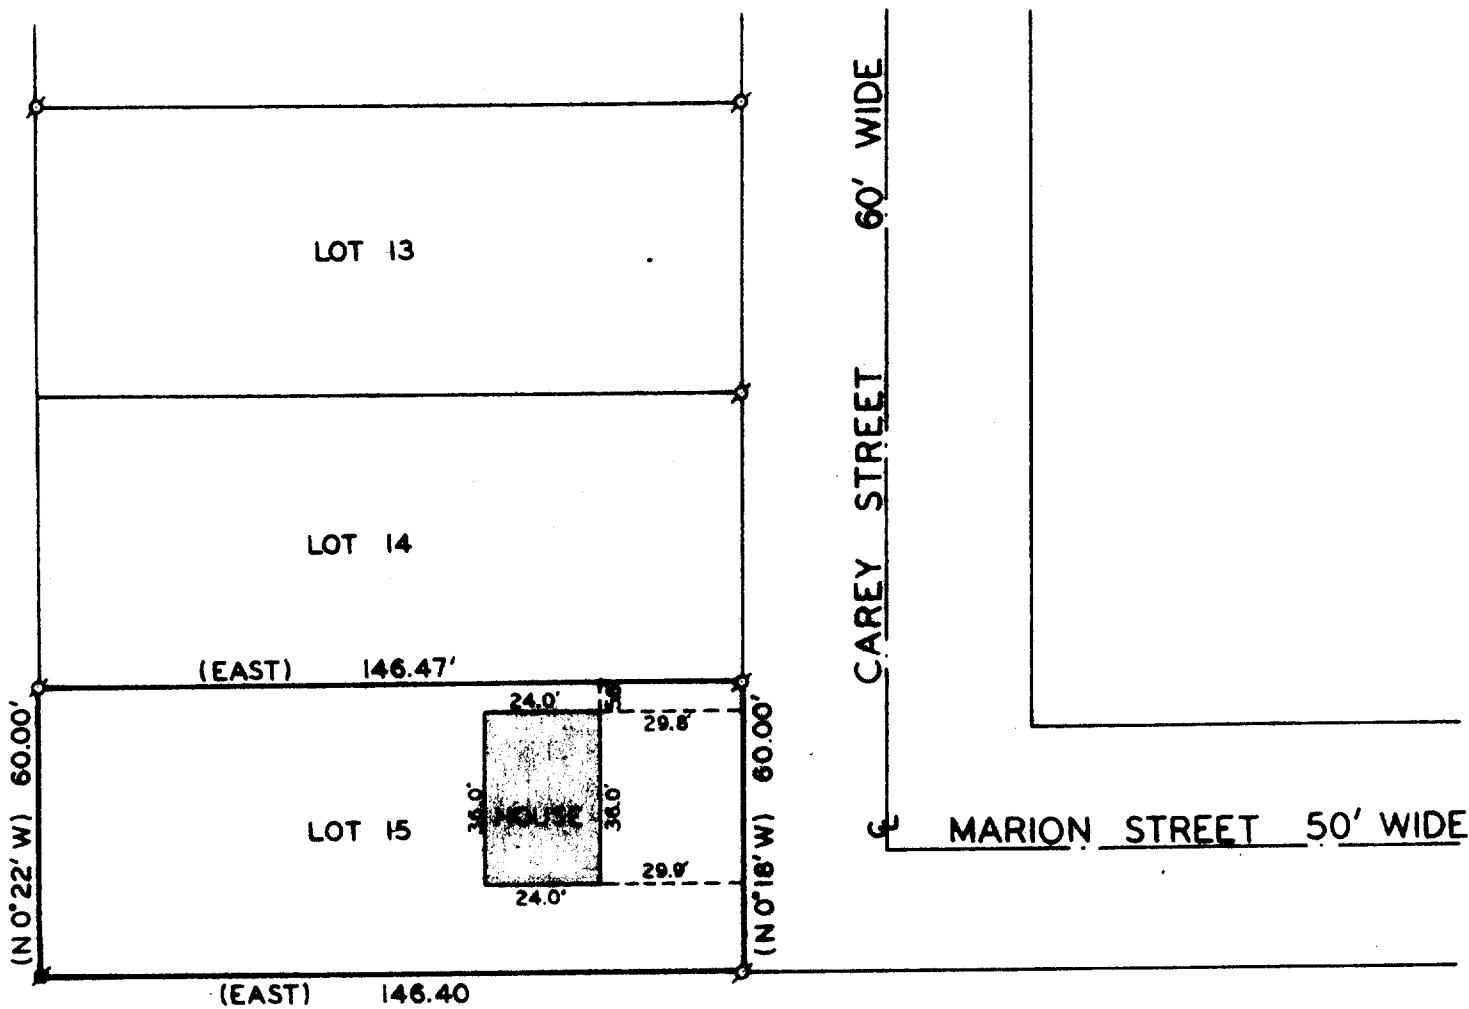

**PLAT OF SURVEY OF**

**LOT 15, TONY AND JULIA PETERS  
ADDITION TO THE CITY OF LAKE  
GENEVA, WALWORTH COUNTY,  
WISCONSIN.**

**OWNER: DAVID MILLER**

**ORDERED BY: LAKE GENEVA REALTY  
LAKE GENEVA, WI  
53147**



I, HAROLD H. KOLB, DO HEREBY CERTIFY THAT I HAVE SURVEYED THE PROPERTY HEREON DESCRIBED ACCORDING TO THE OFFICIAL RECORDS, AND THAT THE PLAT HEREON IS A CORRECT REPRESENTATION OF THE LOT LINES.



**SCALE: 1" = 40'**

**LEGEND**

- ⊙ — IRON PIPE FOUND
- — CONCRETE MONUMENT FOUND
- ( ) — AS PLATTED

*Harold H. Kolb*

**HAROLD H. KOLB  
WISCONSIN REGISTERED LAND SURVEYOR, S-187  
DATE Feb. 10, 1978**