


WHITEWATER, WISCONSIN 53190

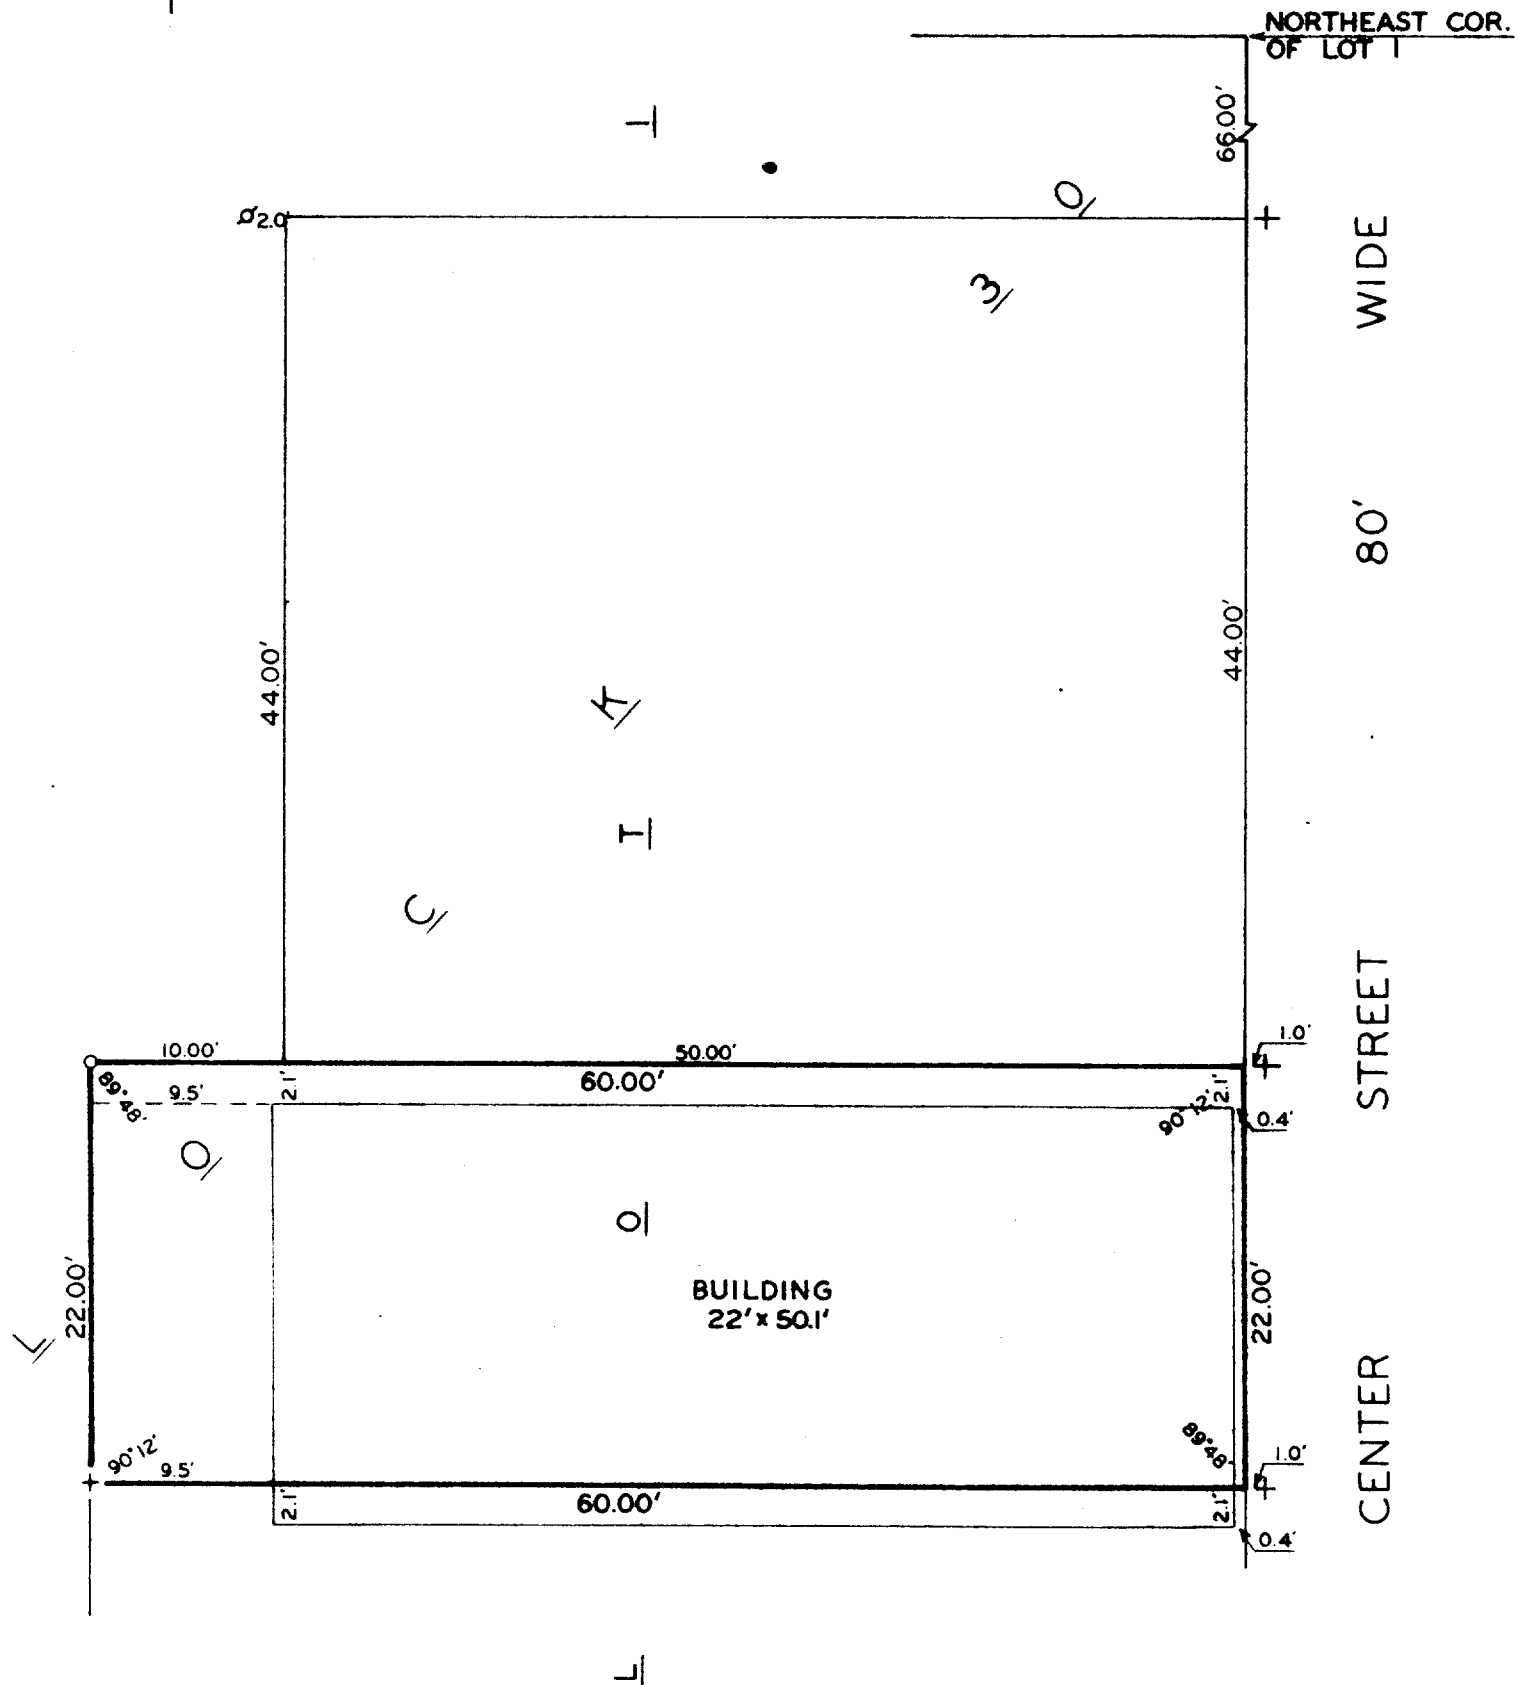

PART OF LOT 1, BLOCK 30, ORIGINAL PLAT OF THE
CITY OF LAKE GENEVA, WALWORTH COUNTY, WISCONSIN.

A circular seal for a Wisconsin Land Surveyor. The outer ring contains the text "WISCONSIN" at the top and "LAND SURVEYOR" at the bottom, separated by two five-pointed stars. The center of the seal contains the name "HAROLD H. KOLB", the license number "S-187", and the location "LAKE GENEVA, WIS."

Harold H. Kall

DATE Dec. 28, 1978

OP-309

7-646K