

HAROLD H. KOLB


REGISTERED PROFESSIONAL LAND SURVEYOR
LAKE GENEVA, WISCONSIN

Park Row 100' Wide

Warren Street 80' Wide

NOTE: IRON PIPE FOUND 0.19'
SOUTH

DETAIL
SCALE: 1"=10'

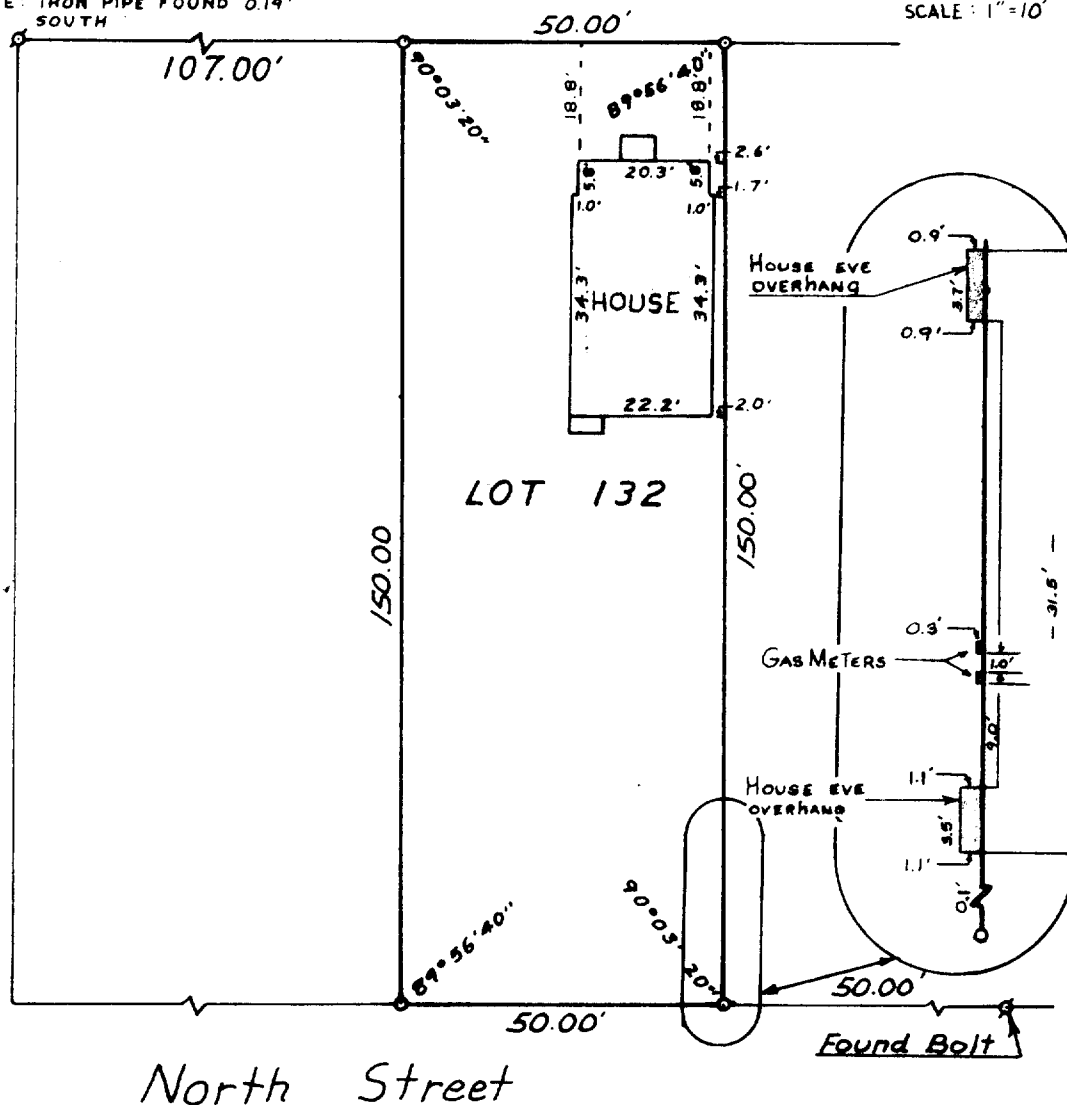

ORDERED BY:

GENE SAUER

PLAT OF SURVEY OF

LOT 132, COLUMBIAN SUBDIVISION
CITY OF LAKE GENEVA, WALWORTH
COUNTY, WISCONSIN.



Scale · 1"=30'

LEGEND

- — IRON PIPE PLACED, 1" x 24" 1.13 LB./LIN. FT.
- — CONCRETE MONUMENT, 5" DIA. x 30"
- ρ — IRON PIPE FOUND

I, HAROLD H. KOLB, DO HEREBY CERTIFY THAT I HAVE
SURVEYED THE PROPERTY HEREON DESCRIBED ACCORDING
TO THE OFFICIAL RECORDS, AND THAT THE PLAT HEREON
IS A CORRECT REPRESENTATION OF THE LOT LINES.

Harold H. Kolb

HAROLD H. KOLB
WISCONSIN REGISTERED LAND SURVEYOR, S-187

DATE May 12, 1978