


HAROLD H. KOLB
REGISTERED PROFESSIONAL LAND SURVEYOR
LAKE GENEVA, WISCONSIN

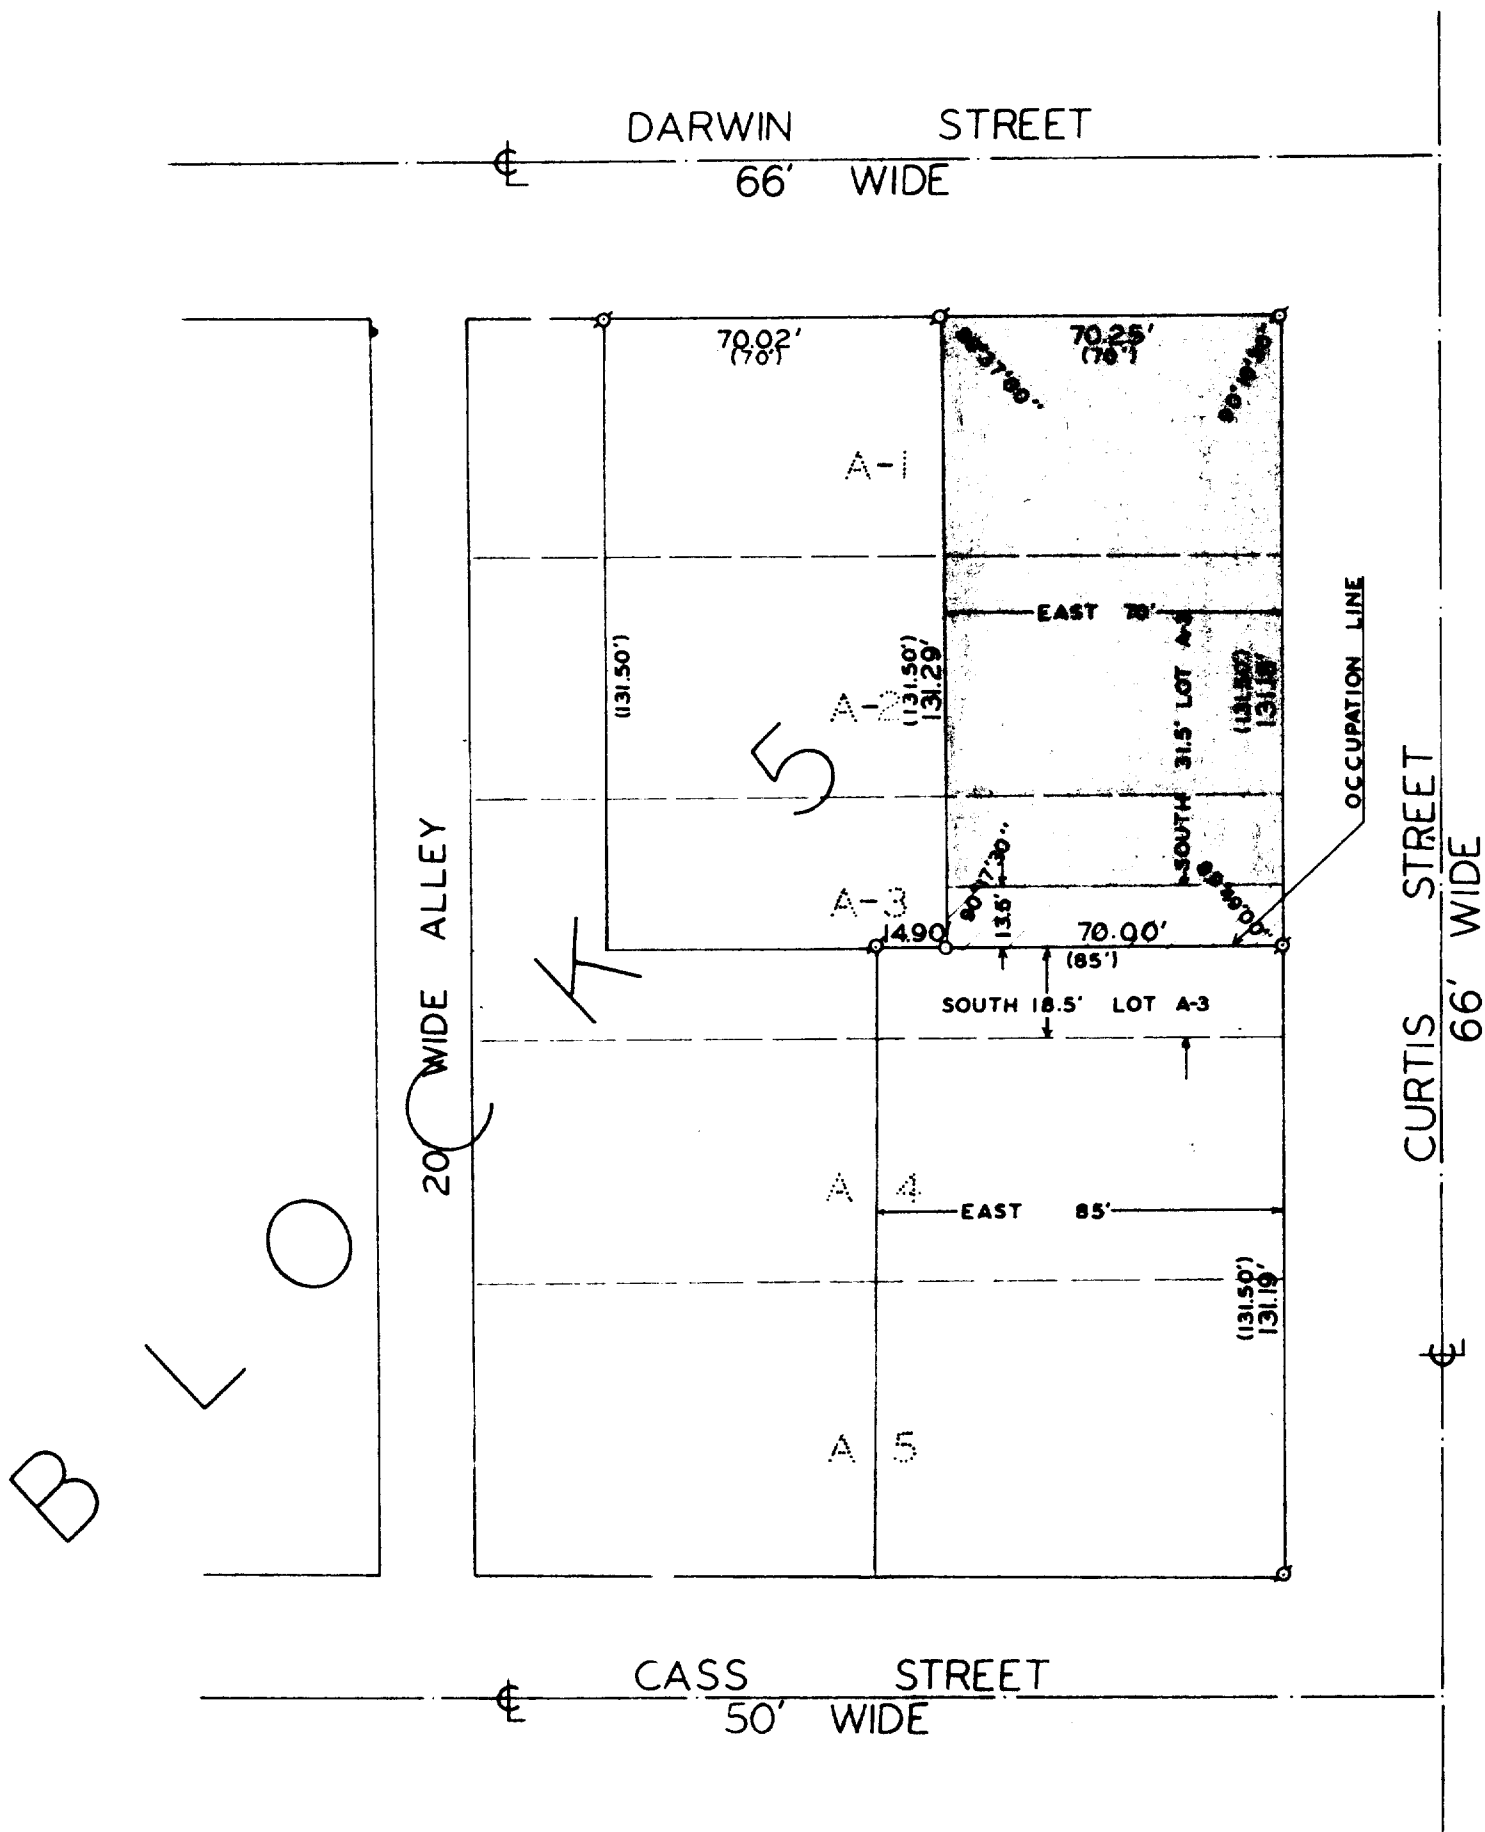

PLAT OF SURVEY OF

PART OF LOTS A-1, A-2 AND A-3, BLOCK 5, PHILLIPS
AND PURVIS SUBDIVISION, CITY OF LAKE GENEVA, WAL-
WORTH COUNTY, WISCONSIN.

NOTE: SHADED AREA AS DESCRIBED IN VOLUME 210, PAGE
139 OF RECORDS---THE ENTIRE EAST 70' OF LOTS
A-1, A-2 AND A-3 IN BLOCK 5 OF PHILLIPS AND
PURVIS SUBDIVISION, CITY OF LAKE GENEVA, WAL-
WORTH COUNTY, WISCONSIN, EXCEPTING THEREFROM
THE SOUTH 31½ FEET OF LOT A-3.

--AREA OCCUPIED BUT NOT INCLUDED IN DESCRIPTION.

ORDERED BY: WALTER VOGEL
RIVER FOREST, ILLINOIS

SCALE: 1" = 40'
LEGEND

- φ — IRON PIPE FOUND
- — IRON PIPE PLACED
- — CONCRETE MONUMENT
- x — SPIKE



I, HAROLD H. KOLB, DO HEREBY CERTIFY THAT I HAVE
SURVEYED THE PROPERTY HEREON DESCRIBED ACCORDING
TO THE OFFICIAL RECORDS, AND THAT THE PLAT HEREON
IS A CORRECT REPRESENTATION OF THE LOT LINES

Harold H. Kolb
HAROLD H. KOLB
WISCONSIN REGISTERED LAND SURVEYOR, S-187
DATE June 20, 1978