
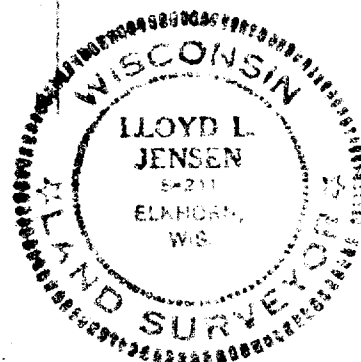


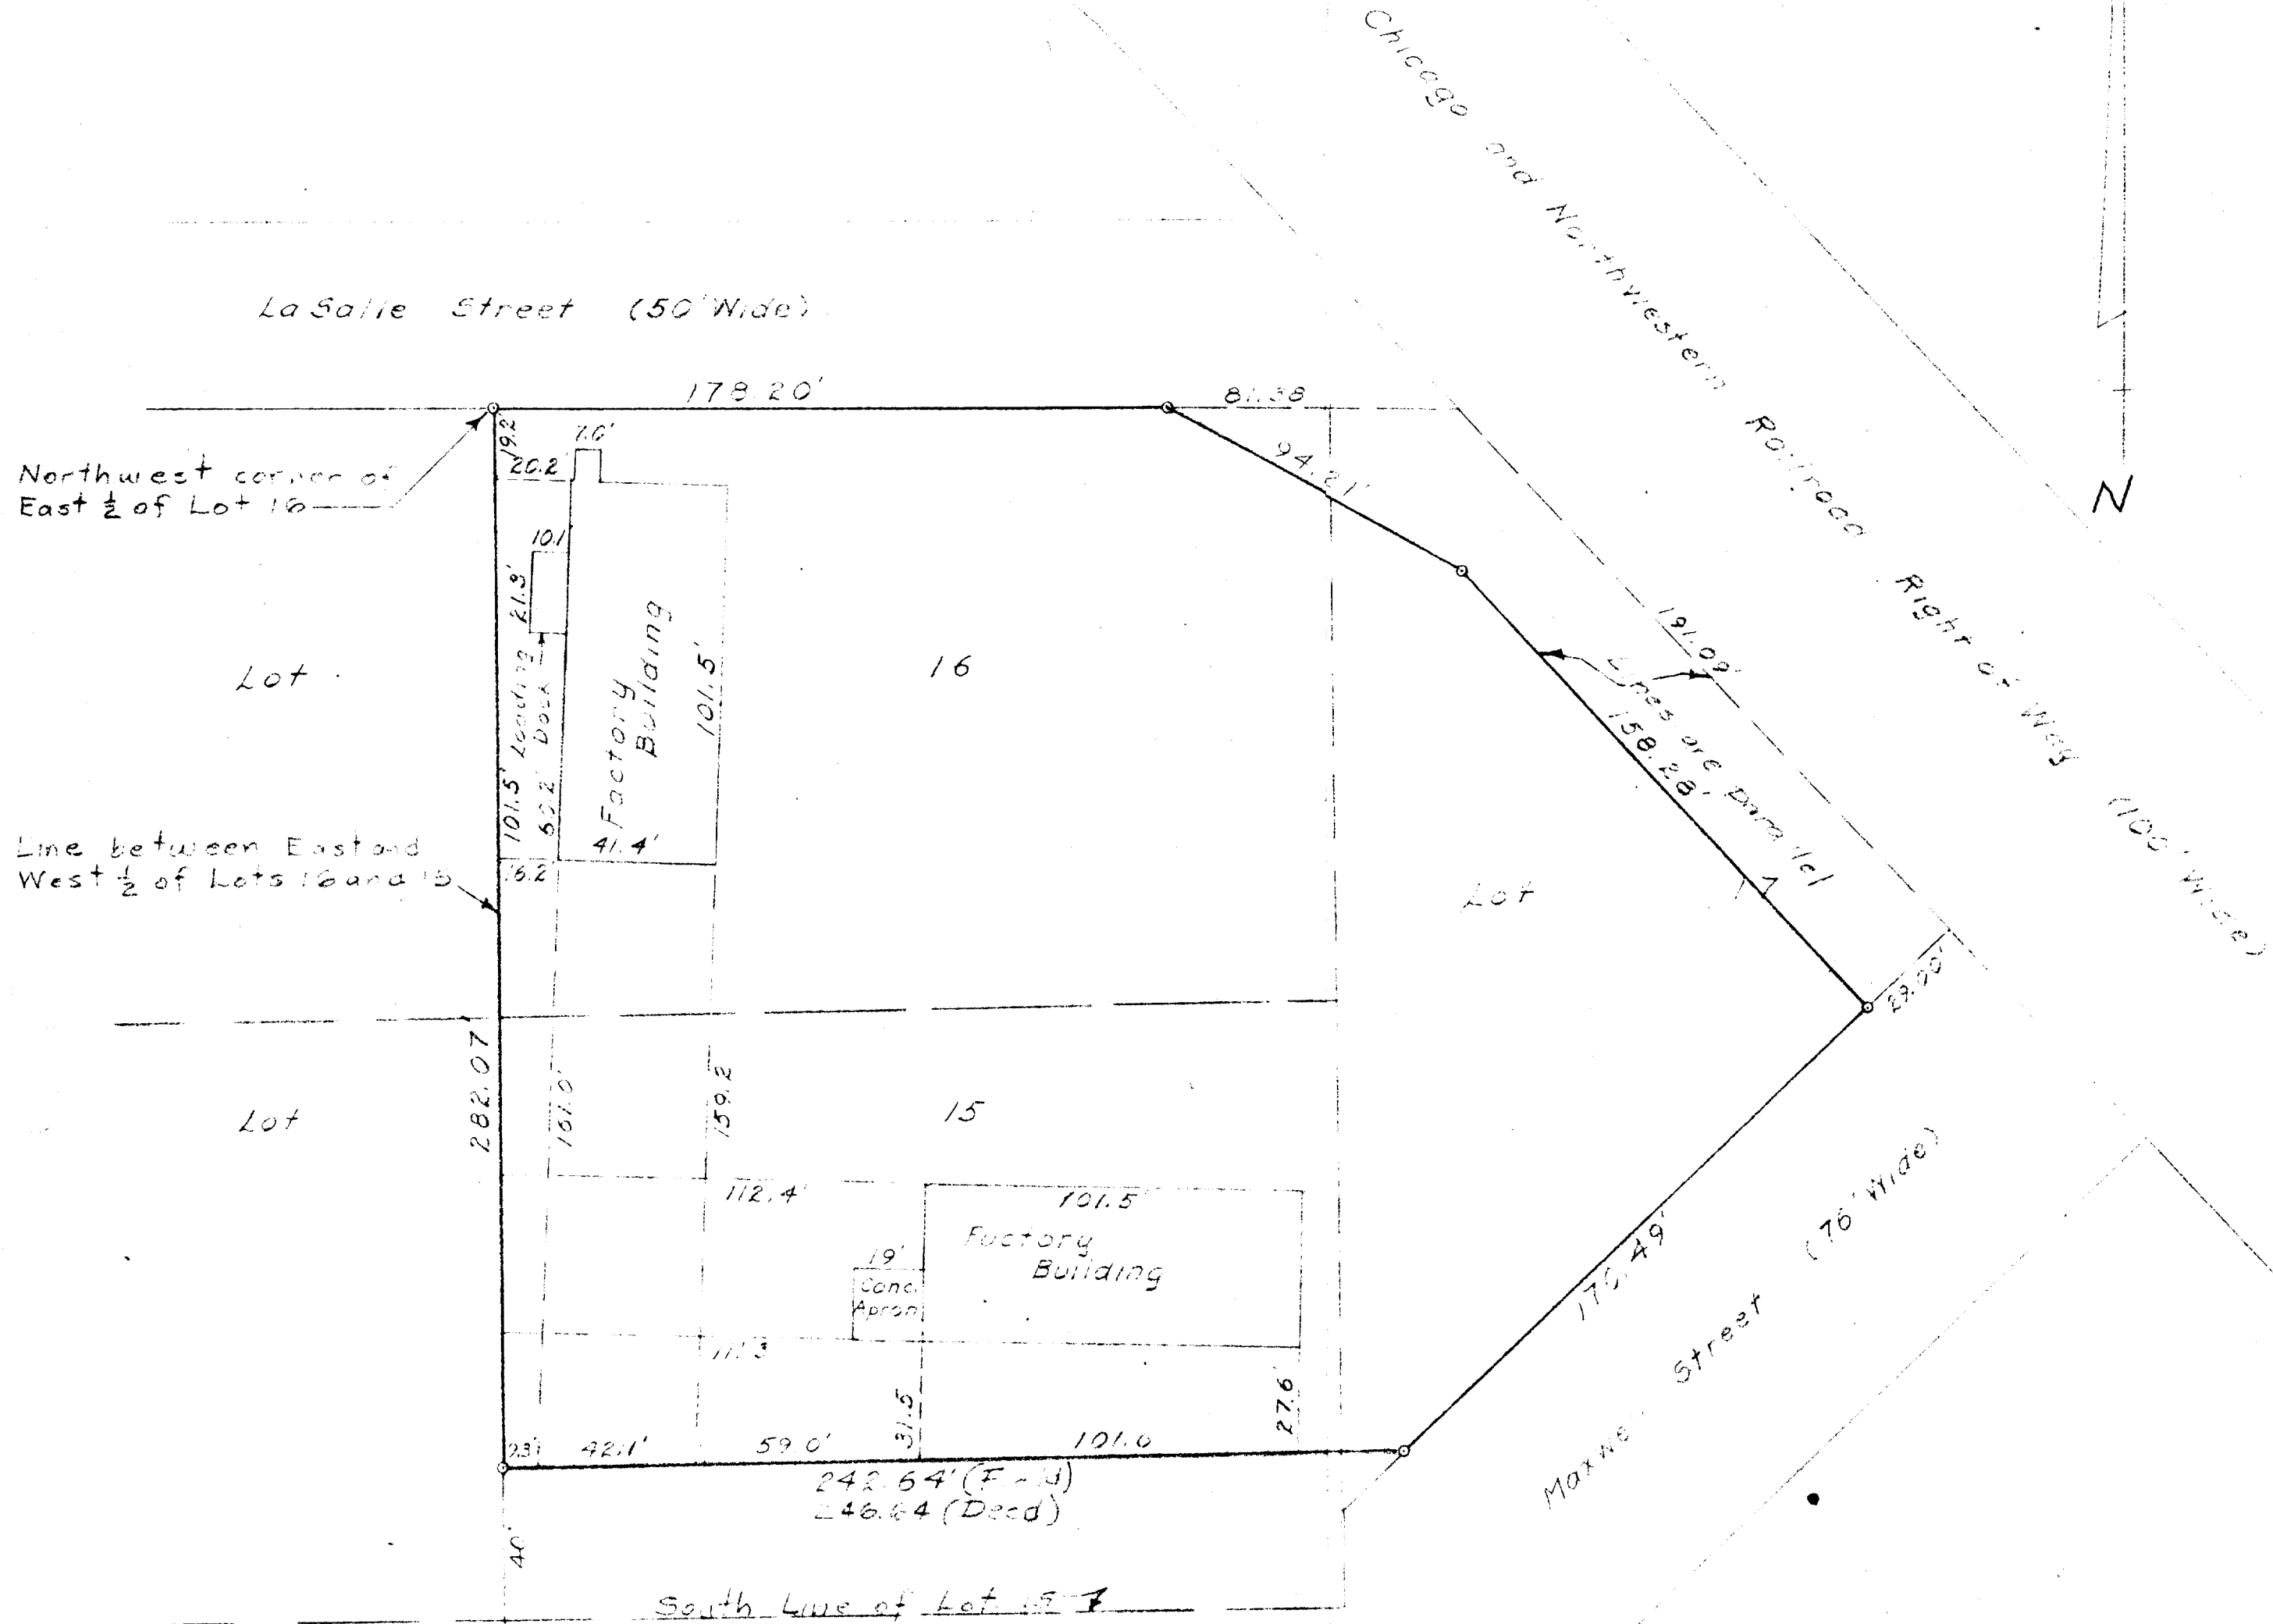

PLAT OF SURVEY OF

Part of Lots 15, 16 and 17, 2nd
Columbian Subdivision, City of
Lake Geneva, Wauwata County,
Wisconsin

Lloyd L. Jensen
SURVEYOR

SCALE 1" = 40'

DATE July, 1960

CL2-14

7-65J