


FARRIS, HANSEN & COOPER, INC.

ENGINEERING, SURVEYING AND LAND PLANNING
715 W. WALWORTH ST. - P.O. BOX 487 - ELKHORN, WI 53121
OFFICE 414/723-2098

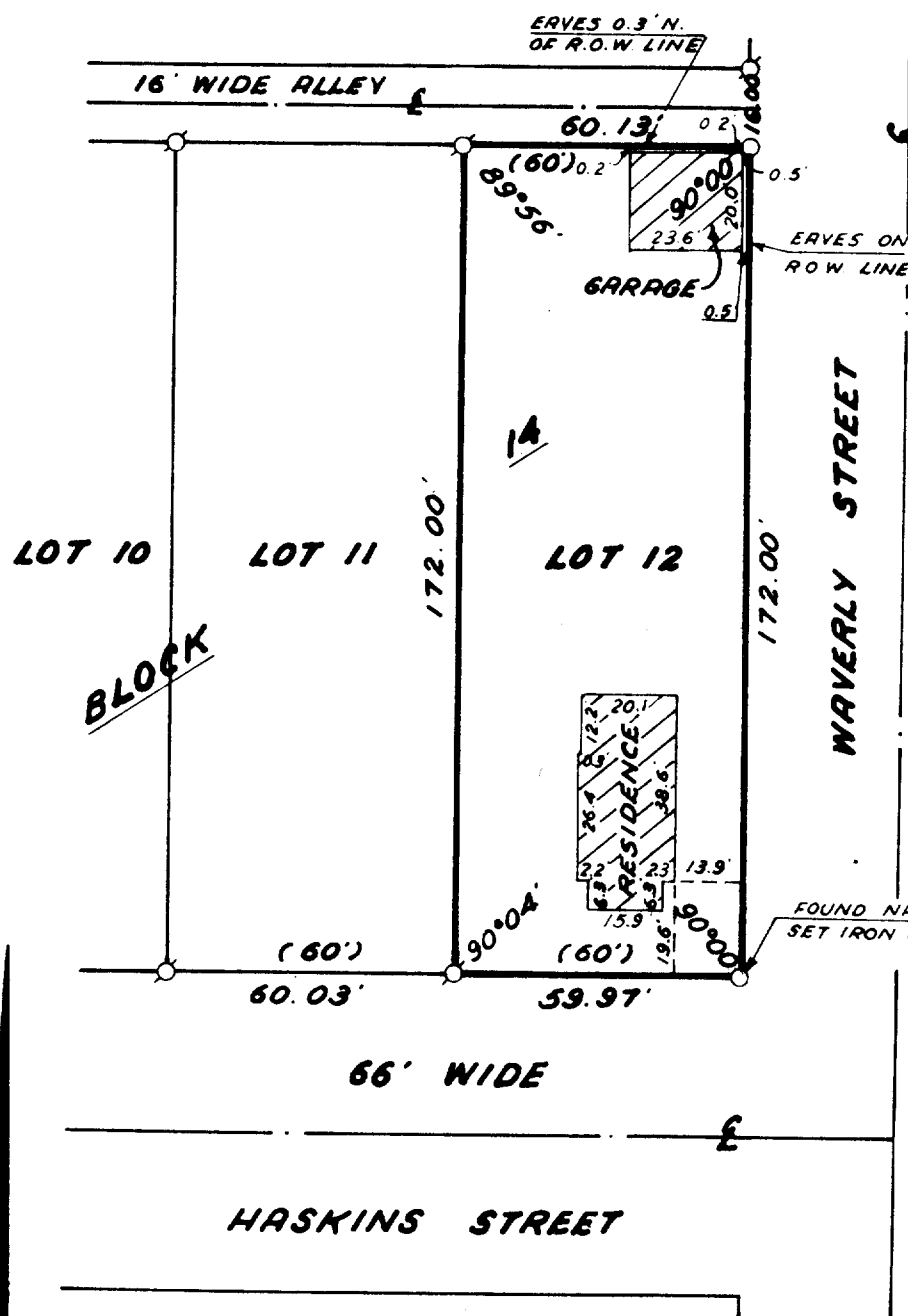

PLAN OF SURVEY OF

Lot 12, Block 14, Geneva Lake Gravel and Manufacturing Company Addition, Section 15, Town of North, Range 17 East, Clinton Lake County, Wisconsin.

ORDERED BY: Great American Funding

Third Trust

SUBJECT: Mrs. Burneister

BUYER: Donald and Barbara Rangel

LEGEND

- ⊙ — 1-3/4" Dia. Iron Pipe Found
- — 1" x 24" Iron Pipe Set
- () — Record Dimension



I, DANIEL D. COOPER, do hereby certify that I have surveyed the above described property and that the above map is a true and correct representation thereof and shows the line and location of the property, its exterior boundaries, the location of all visible structures and foundations of all principal buildings thereon, boundary forces, apparent easements, roadways and all other elements, if any.

This survey is made for the use of the present owners of the property, and for those who purchase, mortgage or otherwise acquire the title thereto within one (1) year from date hereof.

Daniel D. Cooper, SLS No. 1464

Date: 11/14/1979

0 10 20 40
SCALE IN FEET
1"=40'

DRAWING NUMBER 1473

26C-103