


A PARCEL OF LAND LOCATED IN THE NE 1/4
OF SECTION 1, TOWNSHIP 1 NORTH, RANGE 17 EAST
OF THE 4TH PRINCIPAL MERIDIAN IN
LINN TOWNSHIP, WALWORTH COUNTY, WISCONSIN

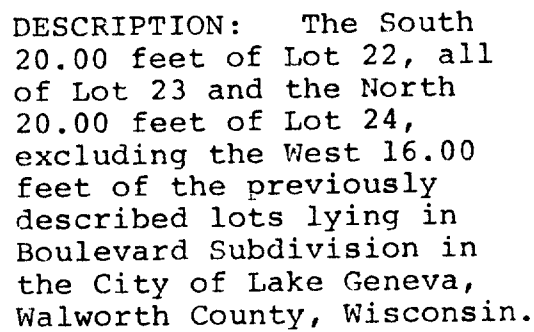


SURVEYOR'S CERTIFICATE:
I hereby certify that I
have surveyed the above
described property and
that the above map is a
true representation
thereof and shows the
size and location of the
property, its exterior
boundaries, the location
of all visible structures
and dimensions of all
principal buildings
thereon, boundary fences,
apparent easements,
roadways and visible
encroachments, if any.
This survey is made for
the use of the present
owners of the property,
and also those who purchase,
mortgage, or guarantee
the title thereto within
one (1) year from date
hereof.

Dennis W. Valentine
Dennis W. Valentine,
RLS 1419

October 8, 1979



Scale 1" = 30'

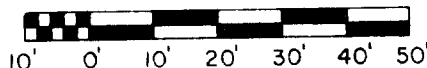

K E Y

- Iron Pipe Found
● Iron Pipe Set

CTY SUR

Prepared By VALENTINE AND ASSOCIATES, INC. DELAVAN, WISCONSIN	Prepared For KEEFE REAL ESTATE LAKE GENEVA, WISCONSIN	Date 10/8/79	Sheet Number 1 of 1
		Job Number 79075	Reference File

137-21

7-684✓