


PLAT OF SURVEY

OF PART OF THE NW. 1/4 OF SEC. 36, T.2N.,
R.17E., CITY OF LAKE GENEVA, WALWORTH CO.,
WISCONSIN.

DESCRIPTION: The North 52 feet of Lot 12 in Block 9 of the Original Plat of the
Village (now City) of Lake Geneva, Walworth County, Wisconsin.

PREPARED FOR: Robert C. and M. Christine Helke, Owners.

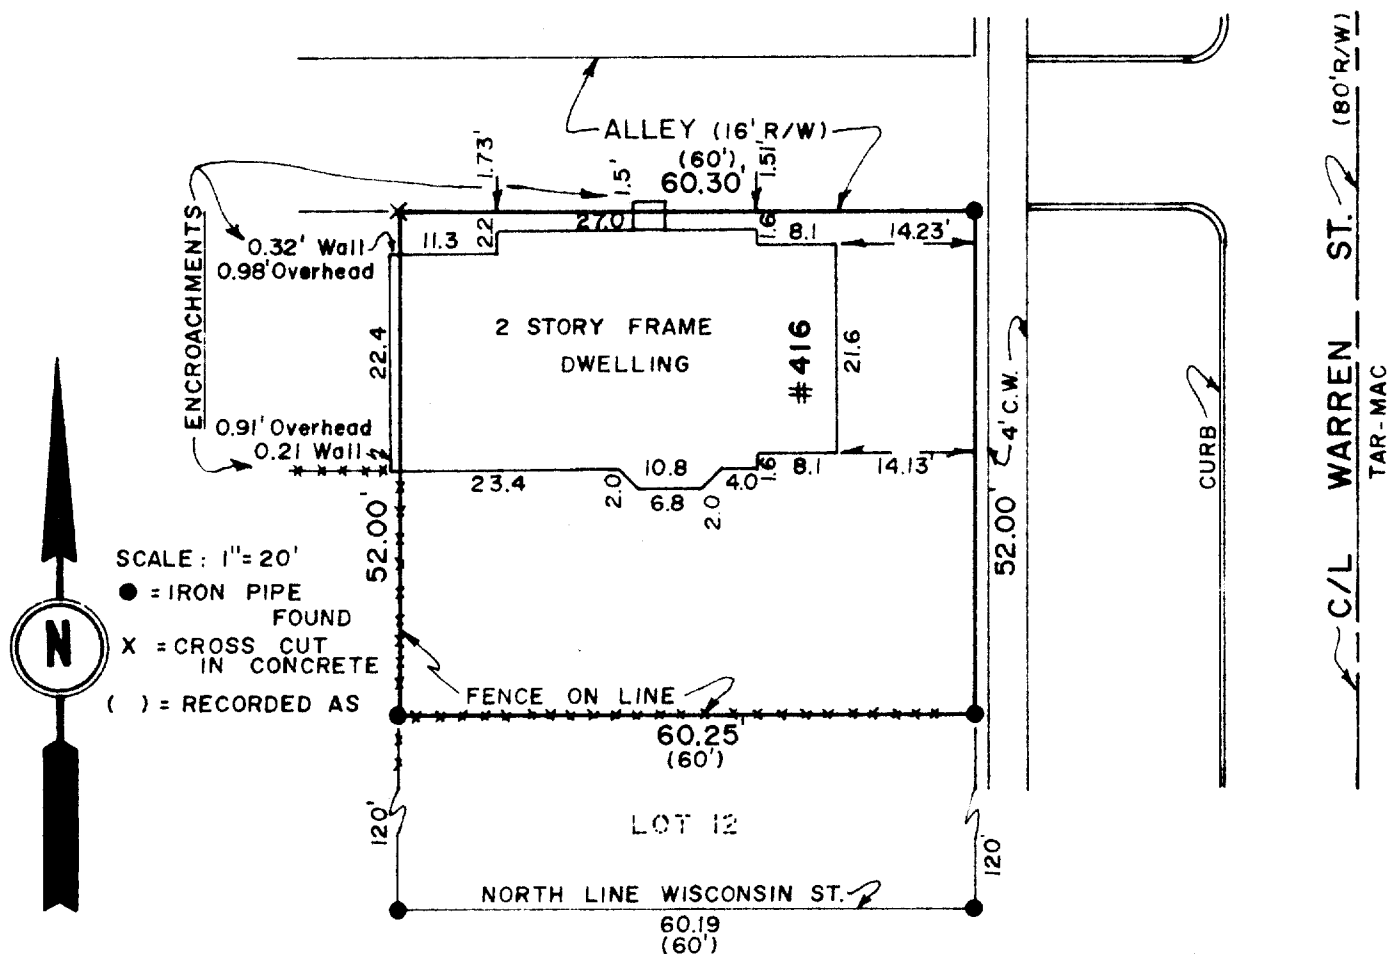

SURVEYOR'S CERTIFICATE: I hereby certify that I have surveyed the above described property and that the above map is a true representation thereof and shows the location of the property, its exterior boundaries, the location of all visible structures and dimensions of all principal buildings thereon. This survey is made for the use of the present owners of the property, and also those who purchase, mortgage, or guarantee the title thereto within one (1) year from date hereof.

Date 6 October 1979

Ralph L. Anderson
Ralph L. Anderson, RLS 1327

Job No. 979

7-686