
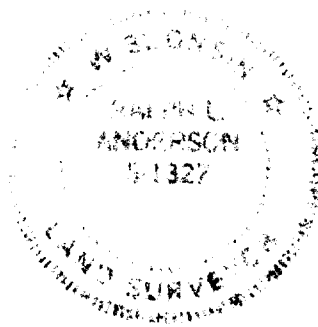


PLAT OF SURVEY

OF PART OF THE NW. 1/4 OF SEC. 36, T.2 N.,
R.17E., CITY OF LAKE GENEVA, WALWORTH CO.,
WISCONSIN

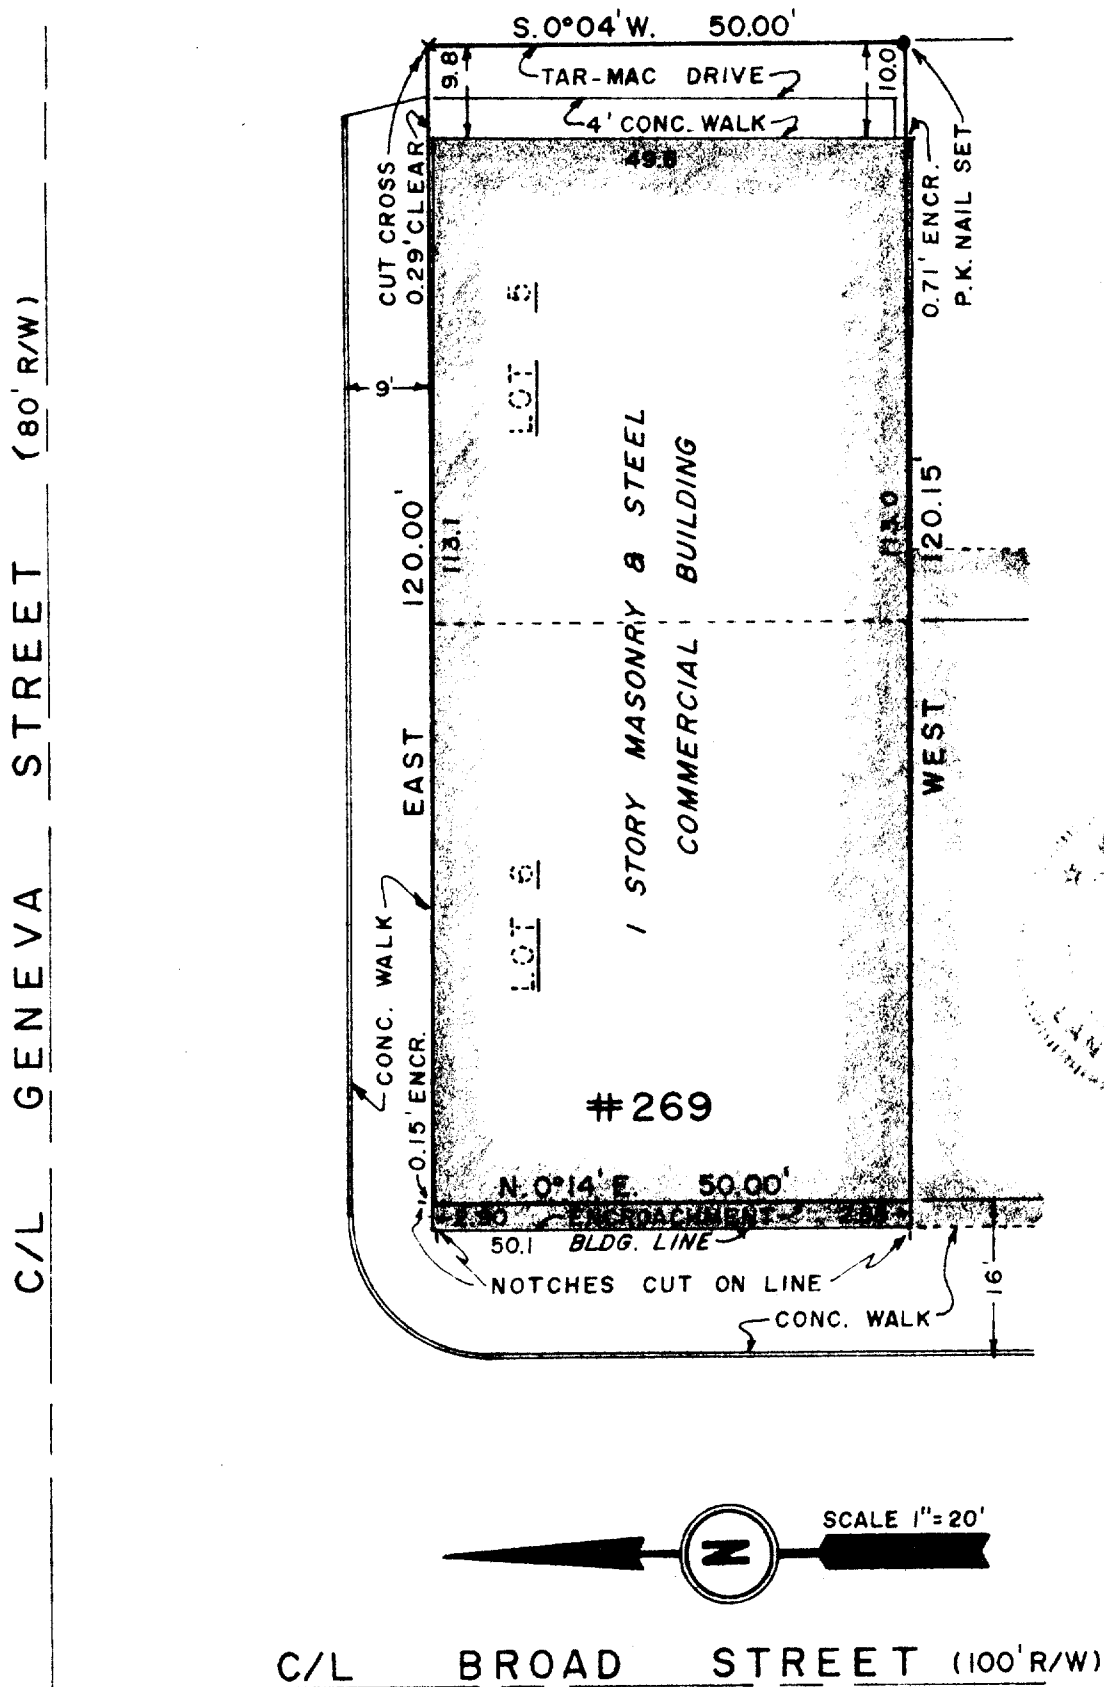

5 Sept. 1979

Ralph L. Anderson