

KOLB LAND CONSULTING, INC.

LAND SURVEYING • SUBDIVIDING • LAND PLANNING

LAKE GENEVA, WISCONSIN 53147


WHITEWATER, WISCONSIN 53190

PARK

ROW

100'

WIDE

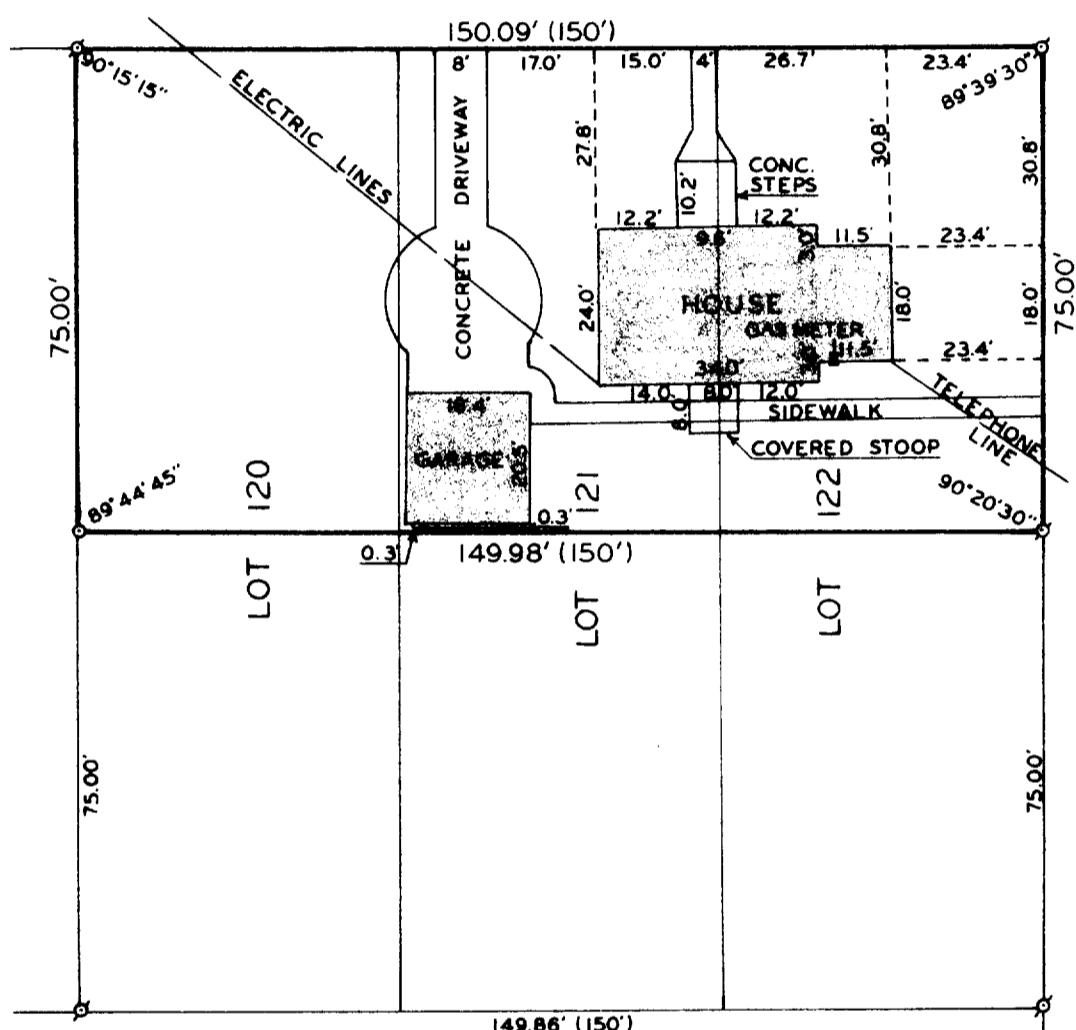

AXWEI STREET : 76' WIDE

PLAT OF SURVEY OF

THE NORTH 1/2 OF LOTS 120, 121, AND 122,
COLUMBIAN SUBDIVISION, CITY OF LAKE
GENEVA, WALWORTH COUNTY, WISCONSIN.

OWNER: FRANK J. HUCK
1204 PARK ROW
LAKE GENEVA, WI 53147

ORDERED BY: STURG TAGGART

I HEREBY CERTIFY THAT I HAVE SURVEYED THE ABOVE DESCRIBED PROPERTY AND THAT THE ABOVE MAP IS A TRUE REPRESENTATION THEREOF AND SHOWS THE SIZE AND LOCATION OF THE PROPERTY, ITS EXTERIOR BOUNDARIES, THE LOCATION OF ALL VISIBLE STRUCTURES AND DIMENSIONS OF ALL PRINCIPAL BUILDINGS THEREON, BOUNDARY FENCES, APPARENT EASEMENTS, ROADWAYS AND VISIBLE ENCROACHMENTS, IF ANY.

THIS SURVEY IS MADE FOR THE USE OF THE
PRESENT OWNERS OF THE PROPERTY, AND ALSO
THOSE WHO PURCHASE, MORTGAGE, OR GUARANTEE
THE TITLE THERETO WITHIN (1) YEAR FROM DATE
HEREOF.

ROBERT M. BAERENWALD
ROBERT M. BAERENWALD
WISCONSIN REGISTERED LAND SURVEYOR, S-1508
DATE 10/16/87

A north arrow pointing upwards, consisting of a black triangle with the letter 'N' in white. Below it is a scale bar with the text 'SCALE : 1" = 30' and 'LEGEND'.

O - IRON PIPE SET
O - IRON PIPE FOUND
() - AS PLATED

34-97

7-687 K ✓