


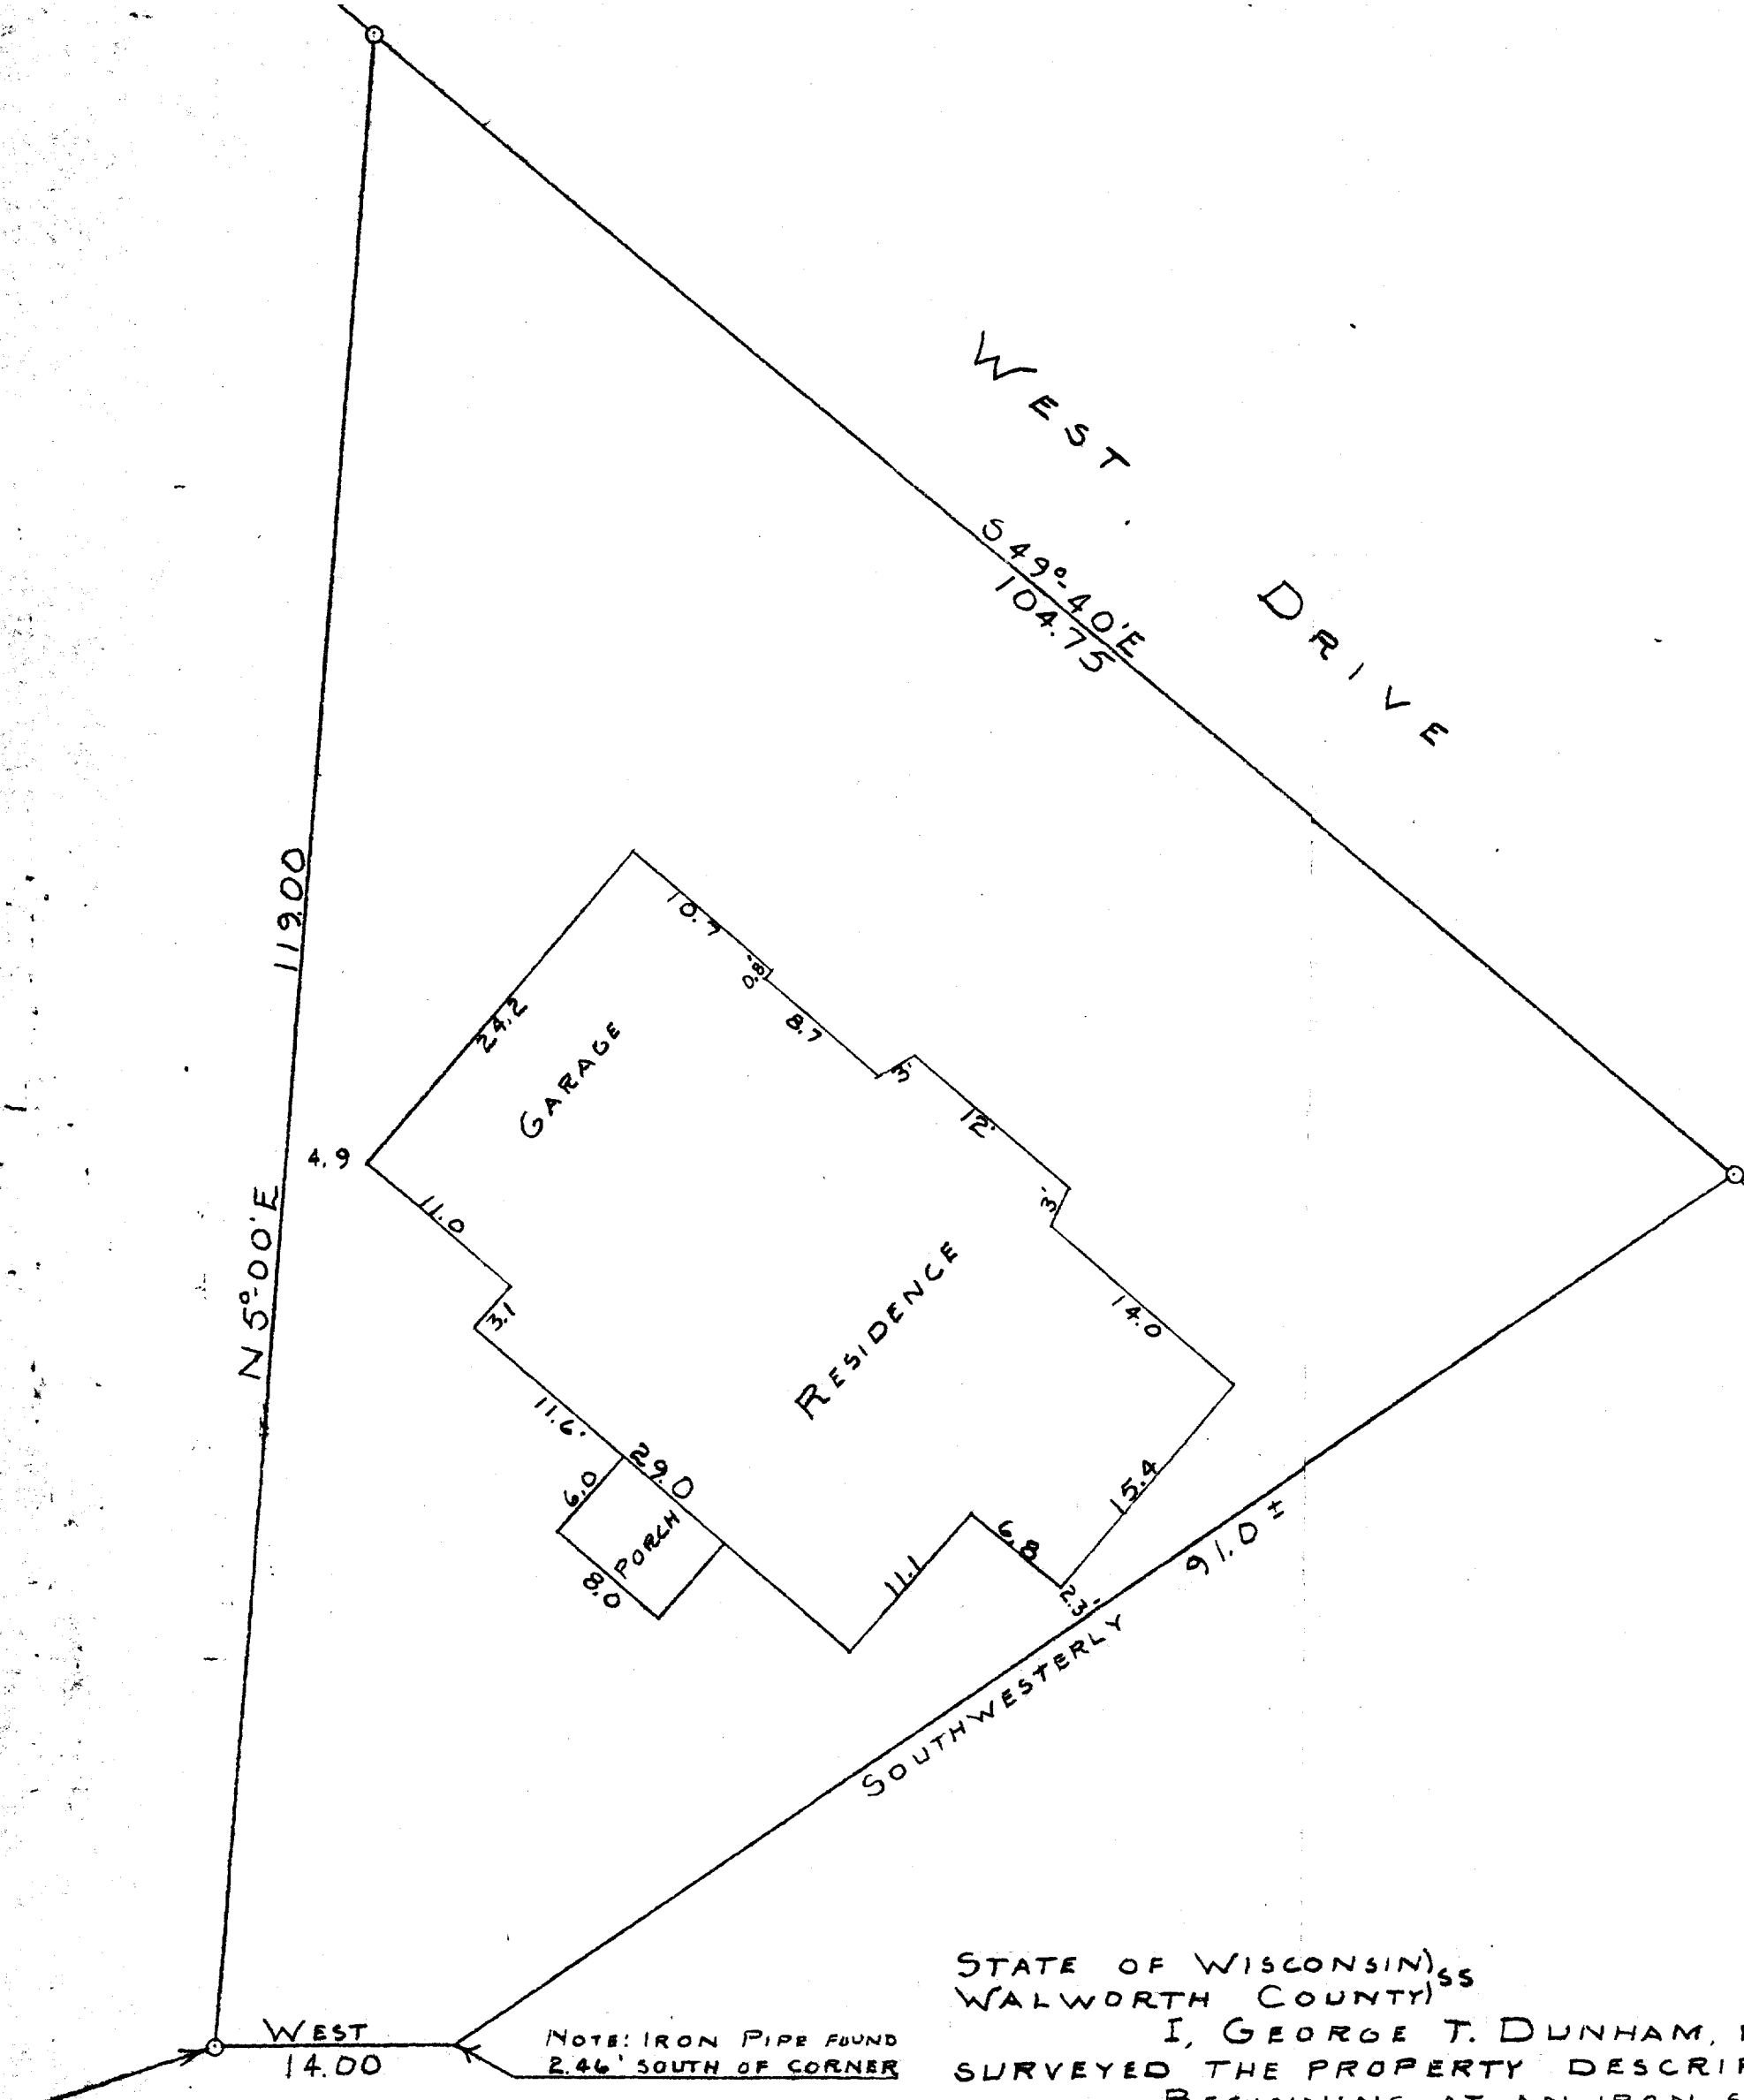

SCALE - 1" = 10'  
O = IRON PIPE

POINT DESCRIBED AS  
BEING LOCATED 186' NORTH  
AND 115' EAST OF THE SOUTH  
WEST CORNER OF SUBLT 15  
OF LARGE LOT 4 OF THE  
ORIGINAL PLAT OF THE CITY  
OF LAKE GENEVA, WALWORTH  
COUNTY WISCONSIN

NOTE: IRON PIPE FOUND  
2.46' SOUTH OF CORNER

STATE OF WISCONSIN)  
WALWORTH COUNTY)

I, GEORGE T. DUNHAM, DO HEREBY CERTIFY THAT I HAVE  
SURVEYED THE PROPERTY DESCRIBED AS FOLLOWS:

BEGINNING AT AN IRON STAKE THAT IS LOCATED 186 FEET  
NORTH AND 115 FEET EAST OF THE SOUTHWEST CORNER OF  
SUBLT 15 OF LARGE LOT 4 OF THE ORIGINAL PLAT OF THE CITY  
OF LAKE GENEVA, WALWORTH COUNTY, WISCONSIN; THENCE N 5° 00' E  
119.00 FEET; THENCE S 49° 40' E 104.75 FEET; THENCE SOUTHWESTERLY  
91.0 FEET MORE OR LESS TO A POINT LOCATED 14.00 FEET EAST  
OF THE PLACE OF BEGINNING; THENCE WEST 14.00 FEET TO THE  
PLACE OF BEGINNING

AND THAT THE PLAT SHOWN ABOVE IS A CORRECT REPRESENTATION OF THE  
PROPERTY LINES AND OF THE IMPROVEMENTS LOCATED THEREON  
DEC. 24, 1958

*George T. Dunham*  
GEORGE T. DUNHAM, SURVEYOR  
WISCONSIN