

ENGINEERING, SURVEYING AND LAND PLANNING
715 W. WALWORTH ST. - P.O. BOX 487 - ELKHORN, WI 53121

Existing parcels in the Geneva Lake Crawford Manufacturing Company's Addition, Section 25, Town 2 North, Range 17 East, City of Lake Geneva, Walworth County, Wisconsin.

PARCEL A: The South 45 feet of Lot 11, Block 6, Geneva Lake Crawford Manufacturing Company Addition to the City of Lake Geneva, Walworth County, Wis.

PARCEL B: The North 15 feet of Lot 11, Block 6 and the South 30 feet of Lot 10, Block 6, Geneva Lake Crawford Manufacturing Company Addition to the City of Lake Geneva, Walworth County, Wisconsin.

ORDERED BY: Jane Freitag
Rich Port Realty

♂—Iron Pipe Found

()—Record Dimension


I HEREBY CERTIFY that I have surveyed the property described, as previously surveyed in 1949, and that this Plat of Survey is a true and accurate representation of the lot lines and buildings thereon to the best of my professional knowledge and belief.

0 5 10 20

SCALE IN FEET
1"=20'

Daniel D. Cooper, RLS 1464
Date: May 30, 1979

ed, as
9,
ey
re,
1
64
9

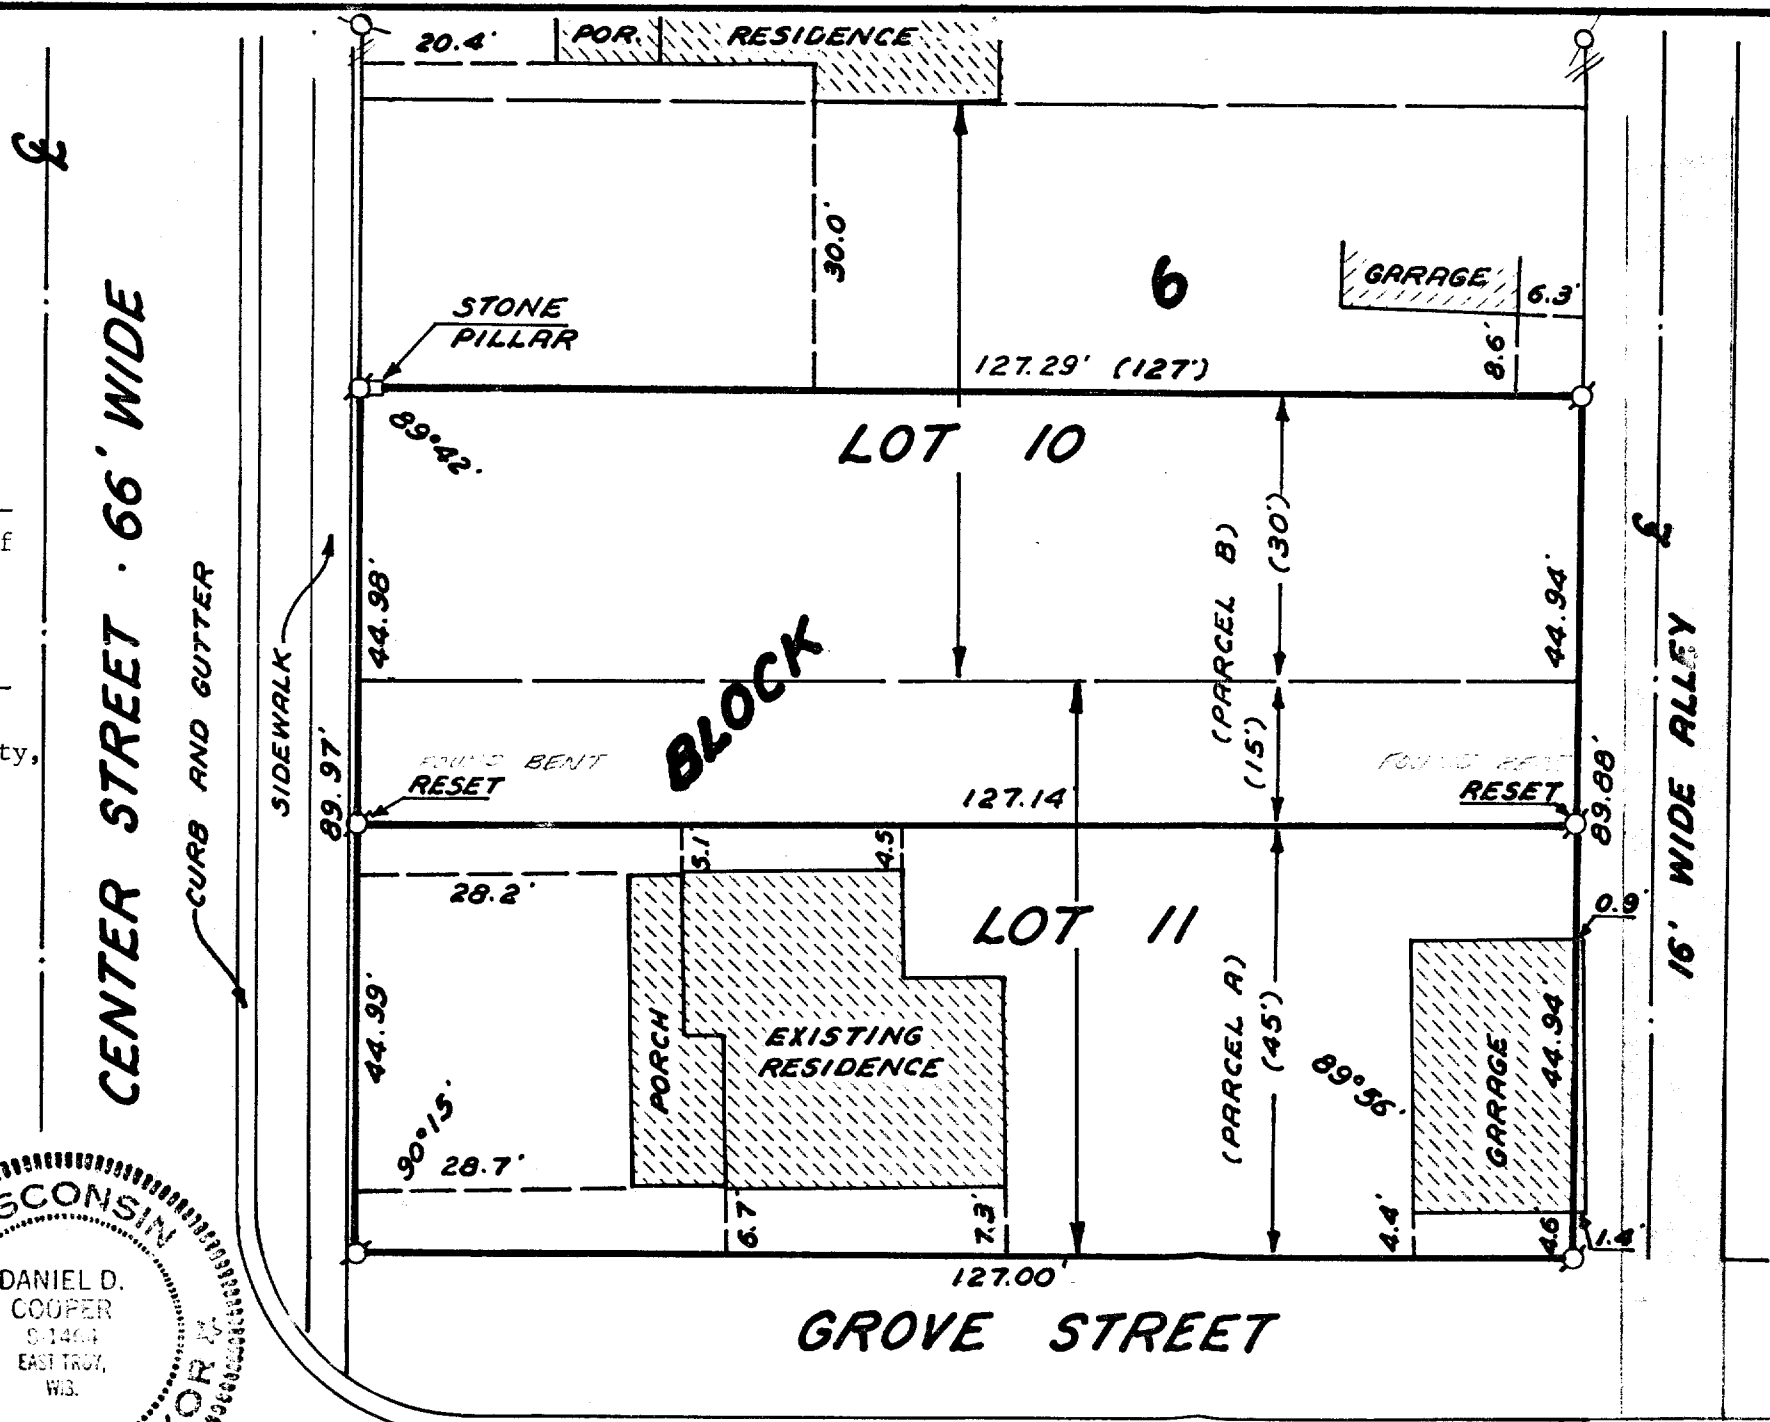

PROJECT NO. 1528

ZGC-17, 174

7-694F