


DUNHAM SURVEYING, S.C.
SURVEYING & SUBDIVIDING
DELAVER, WISCONSIN 53115

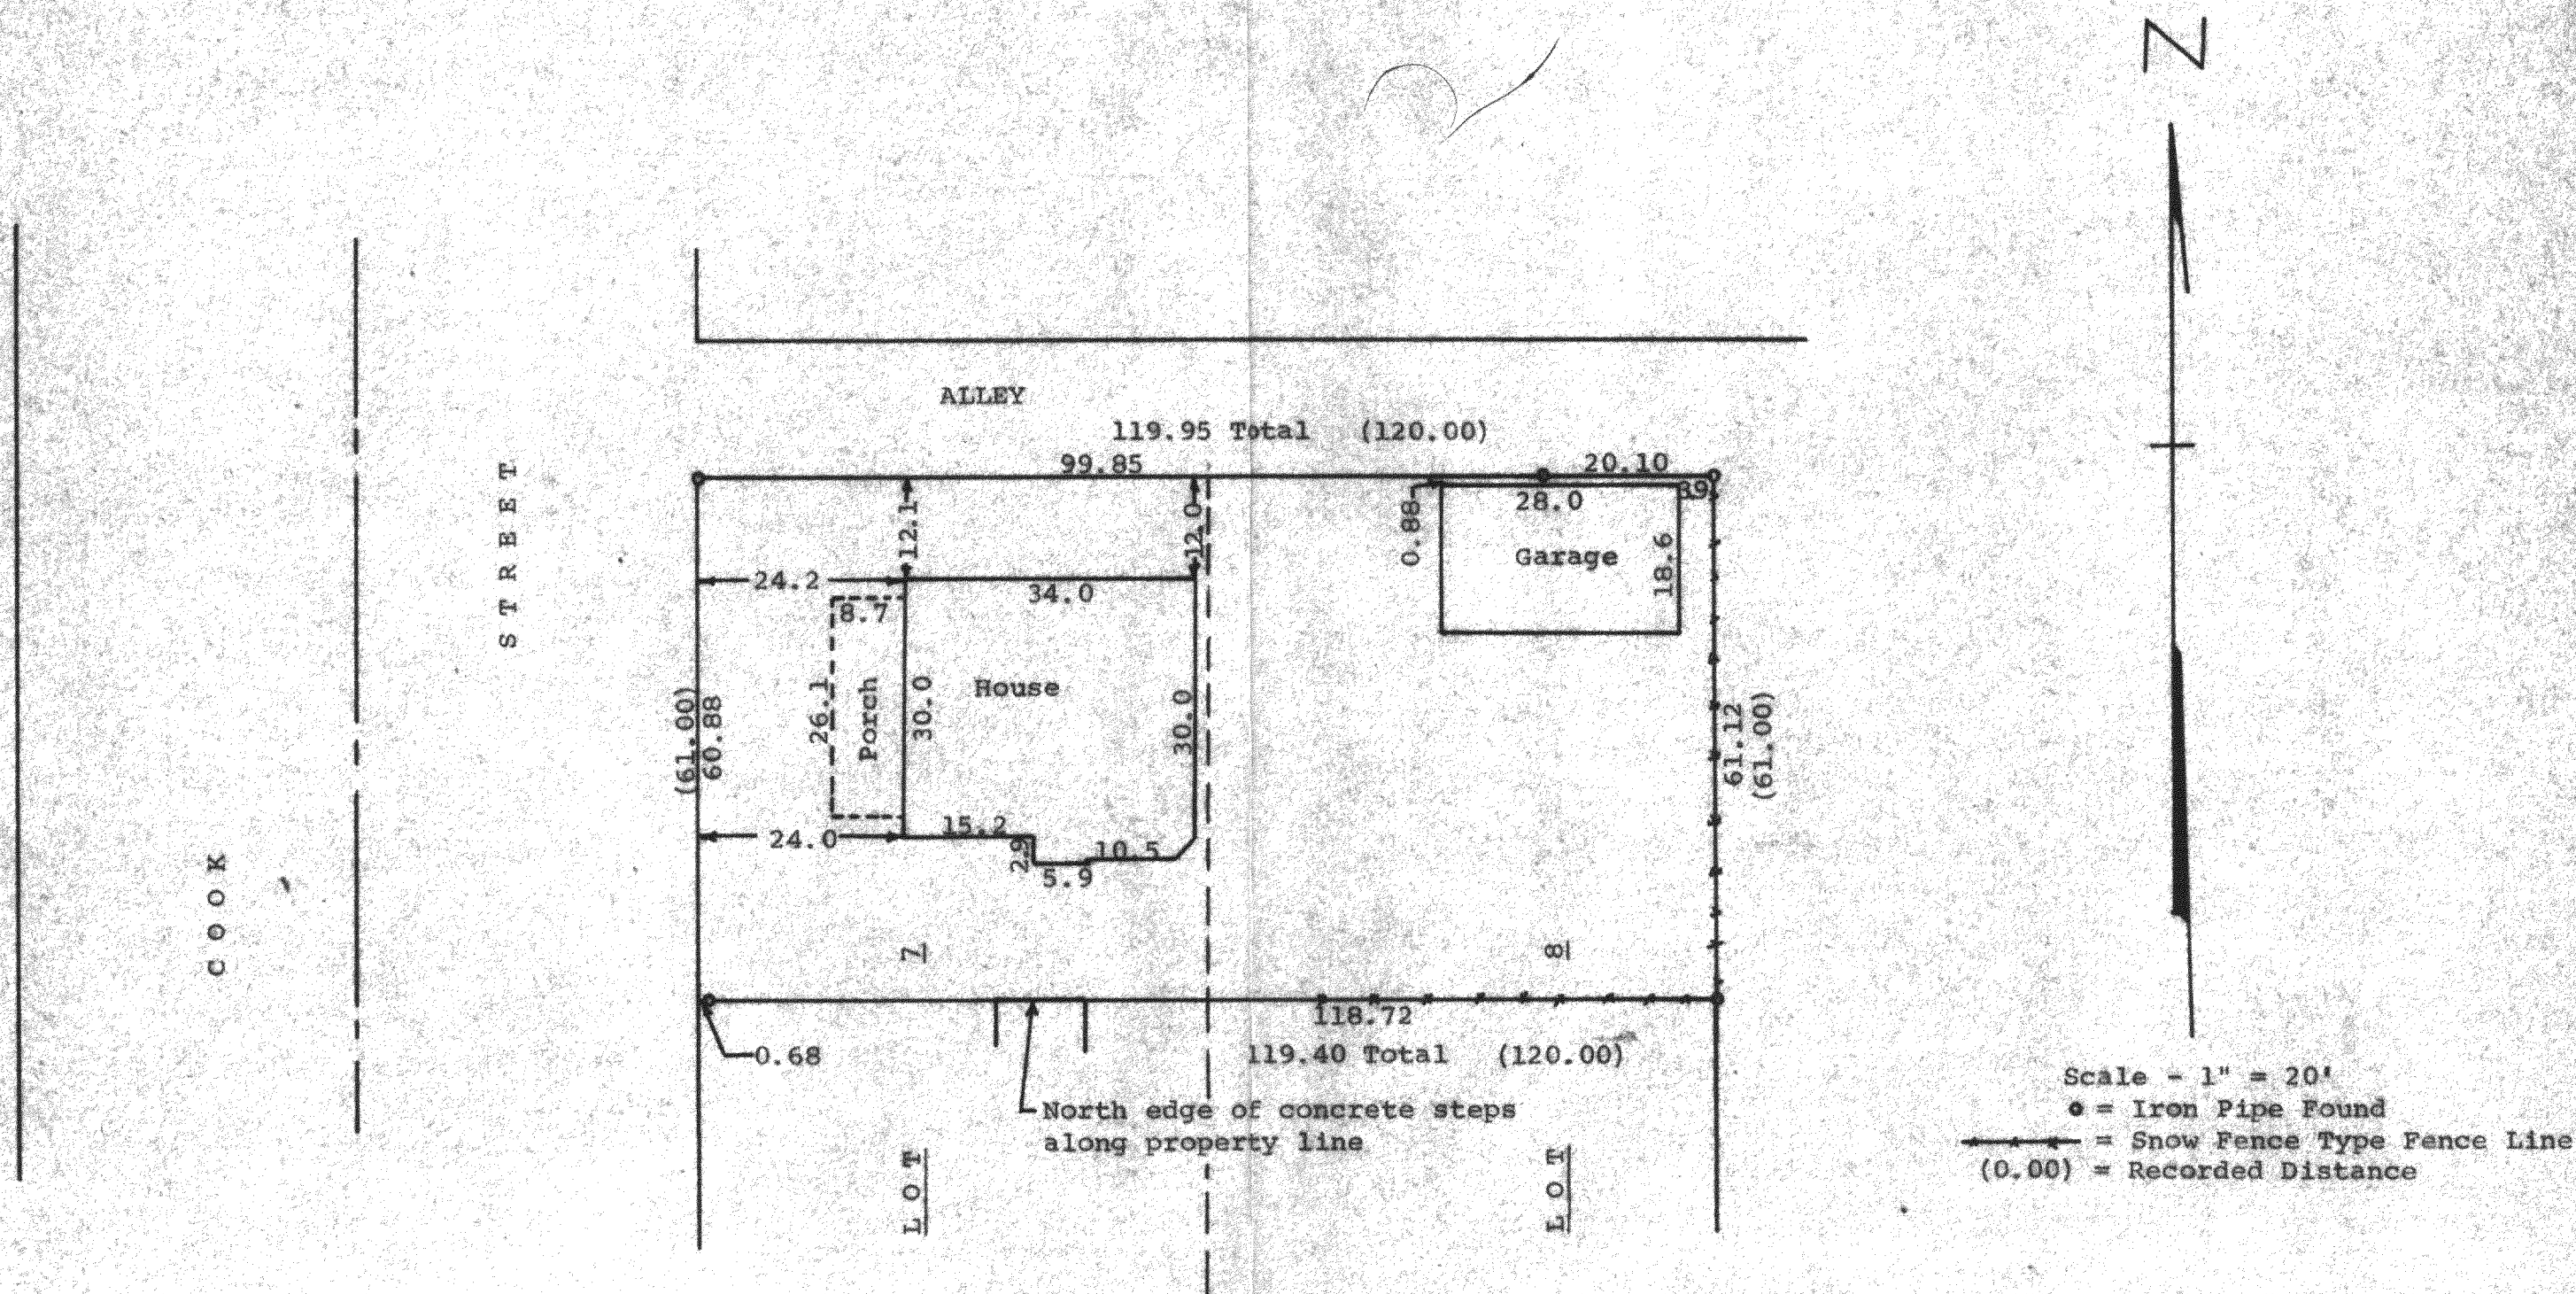

STATE OF WISCONSIN) ss
COUNTY OF WALWORTH)

I, George T. Dunham, Surveyor, certify that I have surveyed the property described as follows:

PARCEL 1: The north $\frac{1}{4}$ of Lots 7 and 8 in Block 17, in the Original Plat of the Village (now City) of Lake Geneva, being a part of Section 36, T2N, R17E, in the City of Lake Geneva, excepting a strip 20 feet wide off the east side of the North $\frac{1}{4}$ of Lot 8 and also excepting the South 25 feet of the North 86 feet of the West 100 feet of Lots 7 and 8 in Block 17.

PARCEL 2: All that part of Lot 8 in Block 17 in the Original Plat of the Village (now City) of Lake Geneva, being in Section 36, T2N, R17E, in the City of Lake Geneva, Walworth County, Wisconsin, described as follows: Commencing at the Northeast corner of said Lot 8; thence South on the east line of said lot 61.00 feet to an iron stake; thence West parallel with the northerly line of said Lot 8, 18.82 feet more or less to an iron stake on the southeasterly boundary line of the so-called Bearder lot; thence North parallel with the east line of Lot 8 along the easterly line of the so-called Bearder lands, to the northerly line of said Lot 8; thence East along the northerly line of said Lot 8 to the place of beginning.

and that the above map is a true representation thereof and shows the size and location of the property, its exterior boundaries, the location of all visible structures and dimensions of all principal buildings thereon, boundary fences, apparent easements, roadways and visible encroachments, if any.

This survey is made for the use of the present owners of the property, and also those who purchase, mortgage, or guarantee the title thereto within one (1) year from date hereof.

May 12, 1980

George T. Dunham
George T. Dunham, Surveyor

