



PLAT OF SURVEY OF: Lot 3 Block 2 of Wheelers Addition, City of Lake Geneva, Walworth County, Wisconsin.

I certify that I have surveyed the above described property and that the plat shown hereon is an accurate survey and a true representation thereof and correctly shows the boundary lines of said property, with no visible encroachments.

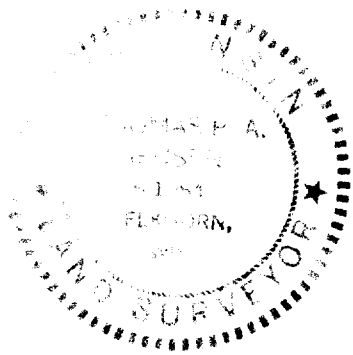

*Thomas P.A. Jensen*

Thomas P.A. Jensen S-1084  
Jensen Surveying & Mapping, S.C.  
45 S. Wisconsin St.  
P.O. Box 322  
Elkhorn, Wis. 53121 414-723-3434

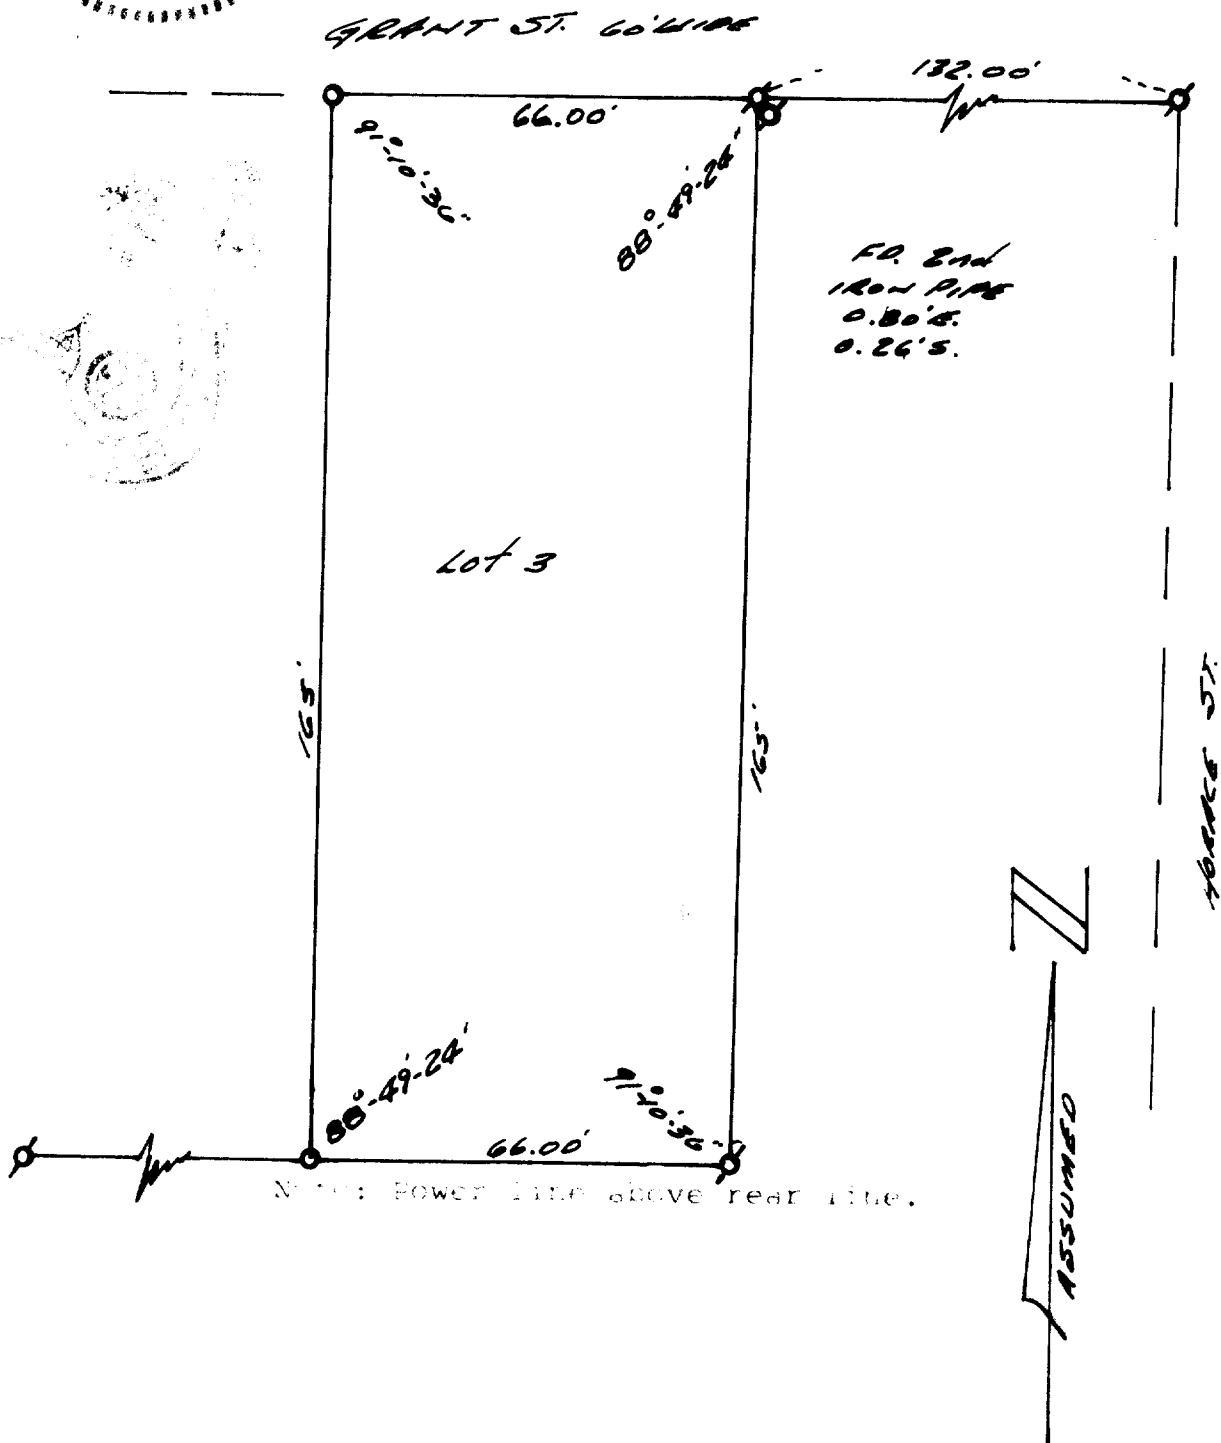

FD. 2nd  
IRON PIPE  
0.80'S.  
0.26'S.



SCALE 1" = 30'  
Ø ~ IRON PIPE FOUND  
O ~ IRON PIPE SET