


KOLB LAND CONSULTING, INC.  
LAND SURVEYING • SUBDIVIDING • LAND PLANNING

LAKE GENEVA, WISCONSIN 53147

WHITEWATER, WISCONSIN 53190

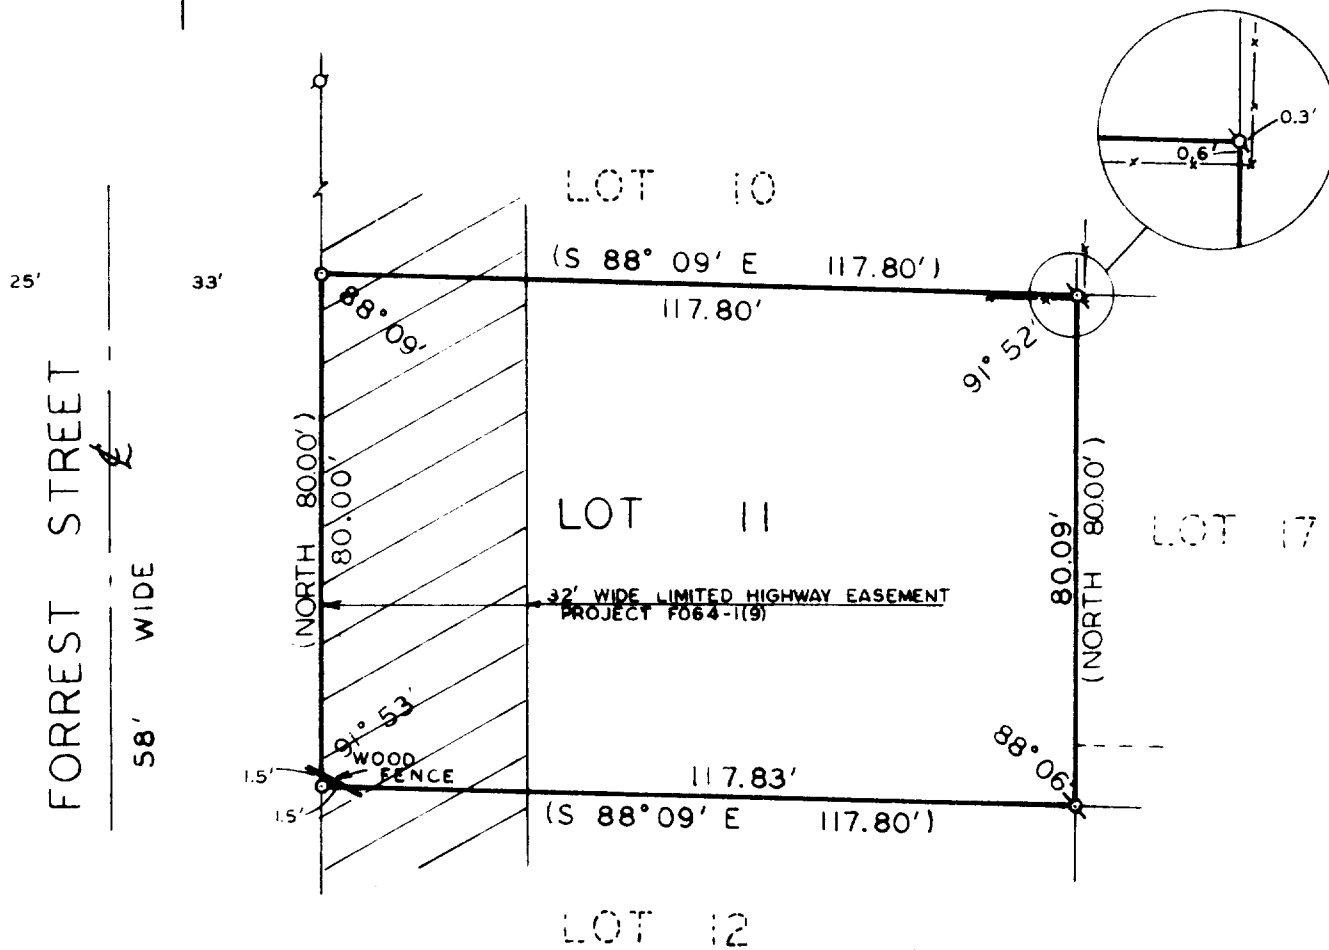


PLAT OF SURVEY OF

LOT 11, PEARSON SUBDIVISION LOCATED IN SECTION  
35, T2N, R17E, CITY OF LAKE GENEVA, WALWORTH  
COUNTY, WISCONSIN.

ORDERED BY: WURTZ CONSTRUCTION, INC.  
100 EAST MAIN STREET  
LAKE GENEVA, WISCONSIN. 53147



SCALE: 1" = 30'

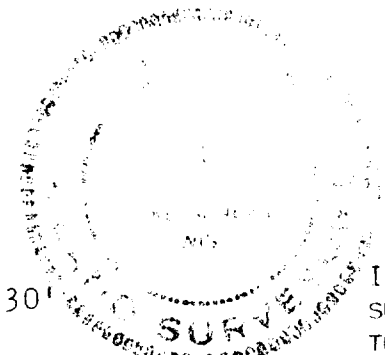

I, HAROLD H. KOLB, DO HEREBY CERTIFY THAT I HAVE  
SURVEYED THE PROPERTY HEREON DESCRIBED ACCORDING  
TO THE OFFICIAL RECORDS, AND THAT THE PLAT HEREON  
IS A CORRECT REPRESENTATION OF THE LOT LINES TO  
THE BEST OF MY KNOWLEDGE AND BELIEF.

LEGEND

- - IRON PIPE SET
- ⊗ - IRON PIPE FOUND
- x— FENCE LINE
- ( ) - RECORDED AS

*Harold H. Kolb*

HAROLD H. KOLB  
WISCONSIN REGISTERED LAND SURVEYOR, S- 187

DATE Dec 5, 1980