


PLAT OF SURVEY

LOTS 11,12,14 AND
PART OF LOT 10 BLOCK 18
LAKE GENEVA MANOR SUBDIVISION
LOCATED IN THE CITY OF LAKE GENEVA
WALWORTH COUNTY, WISCONSIN

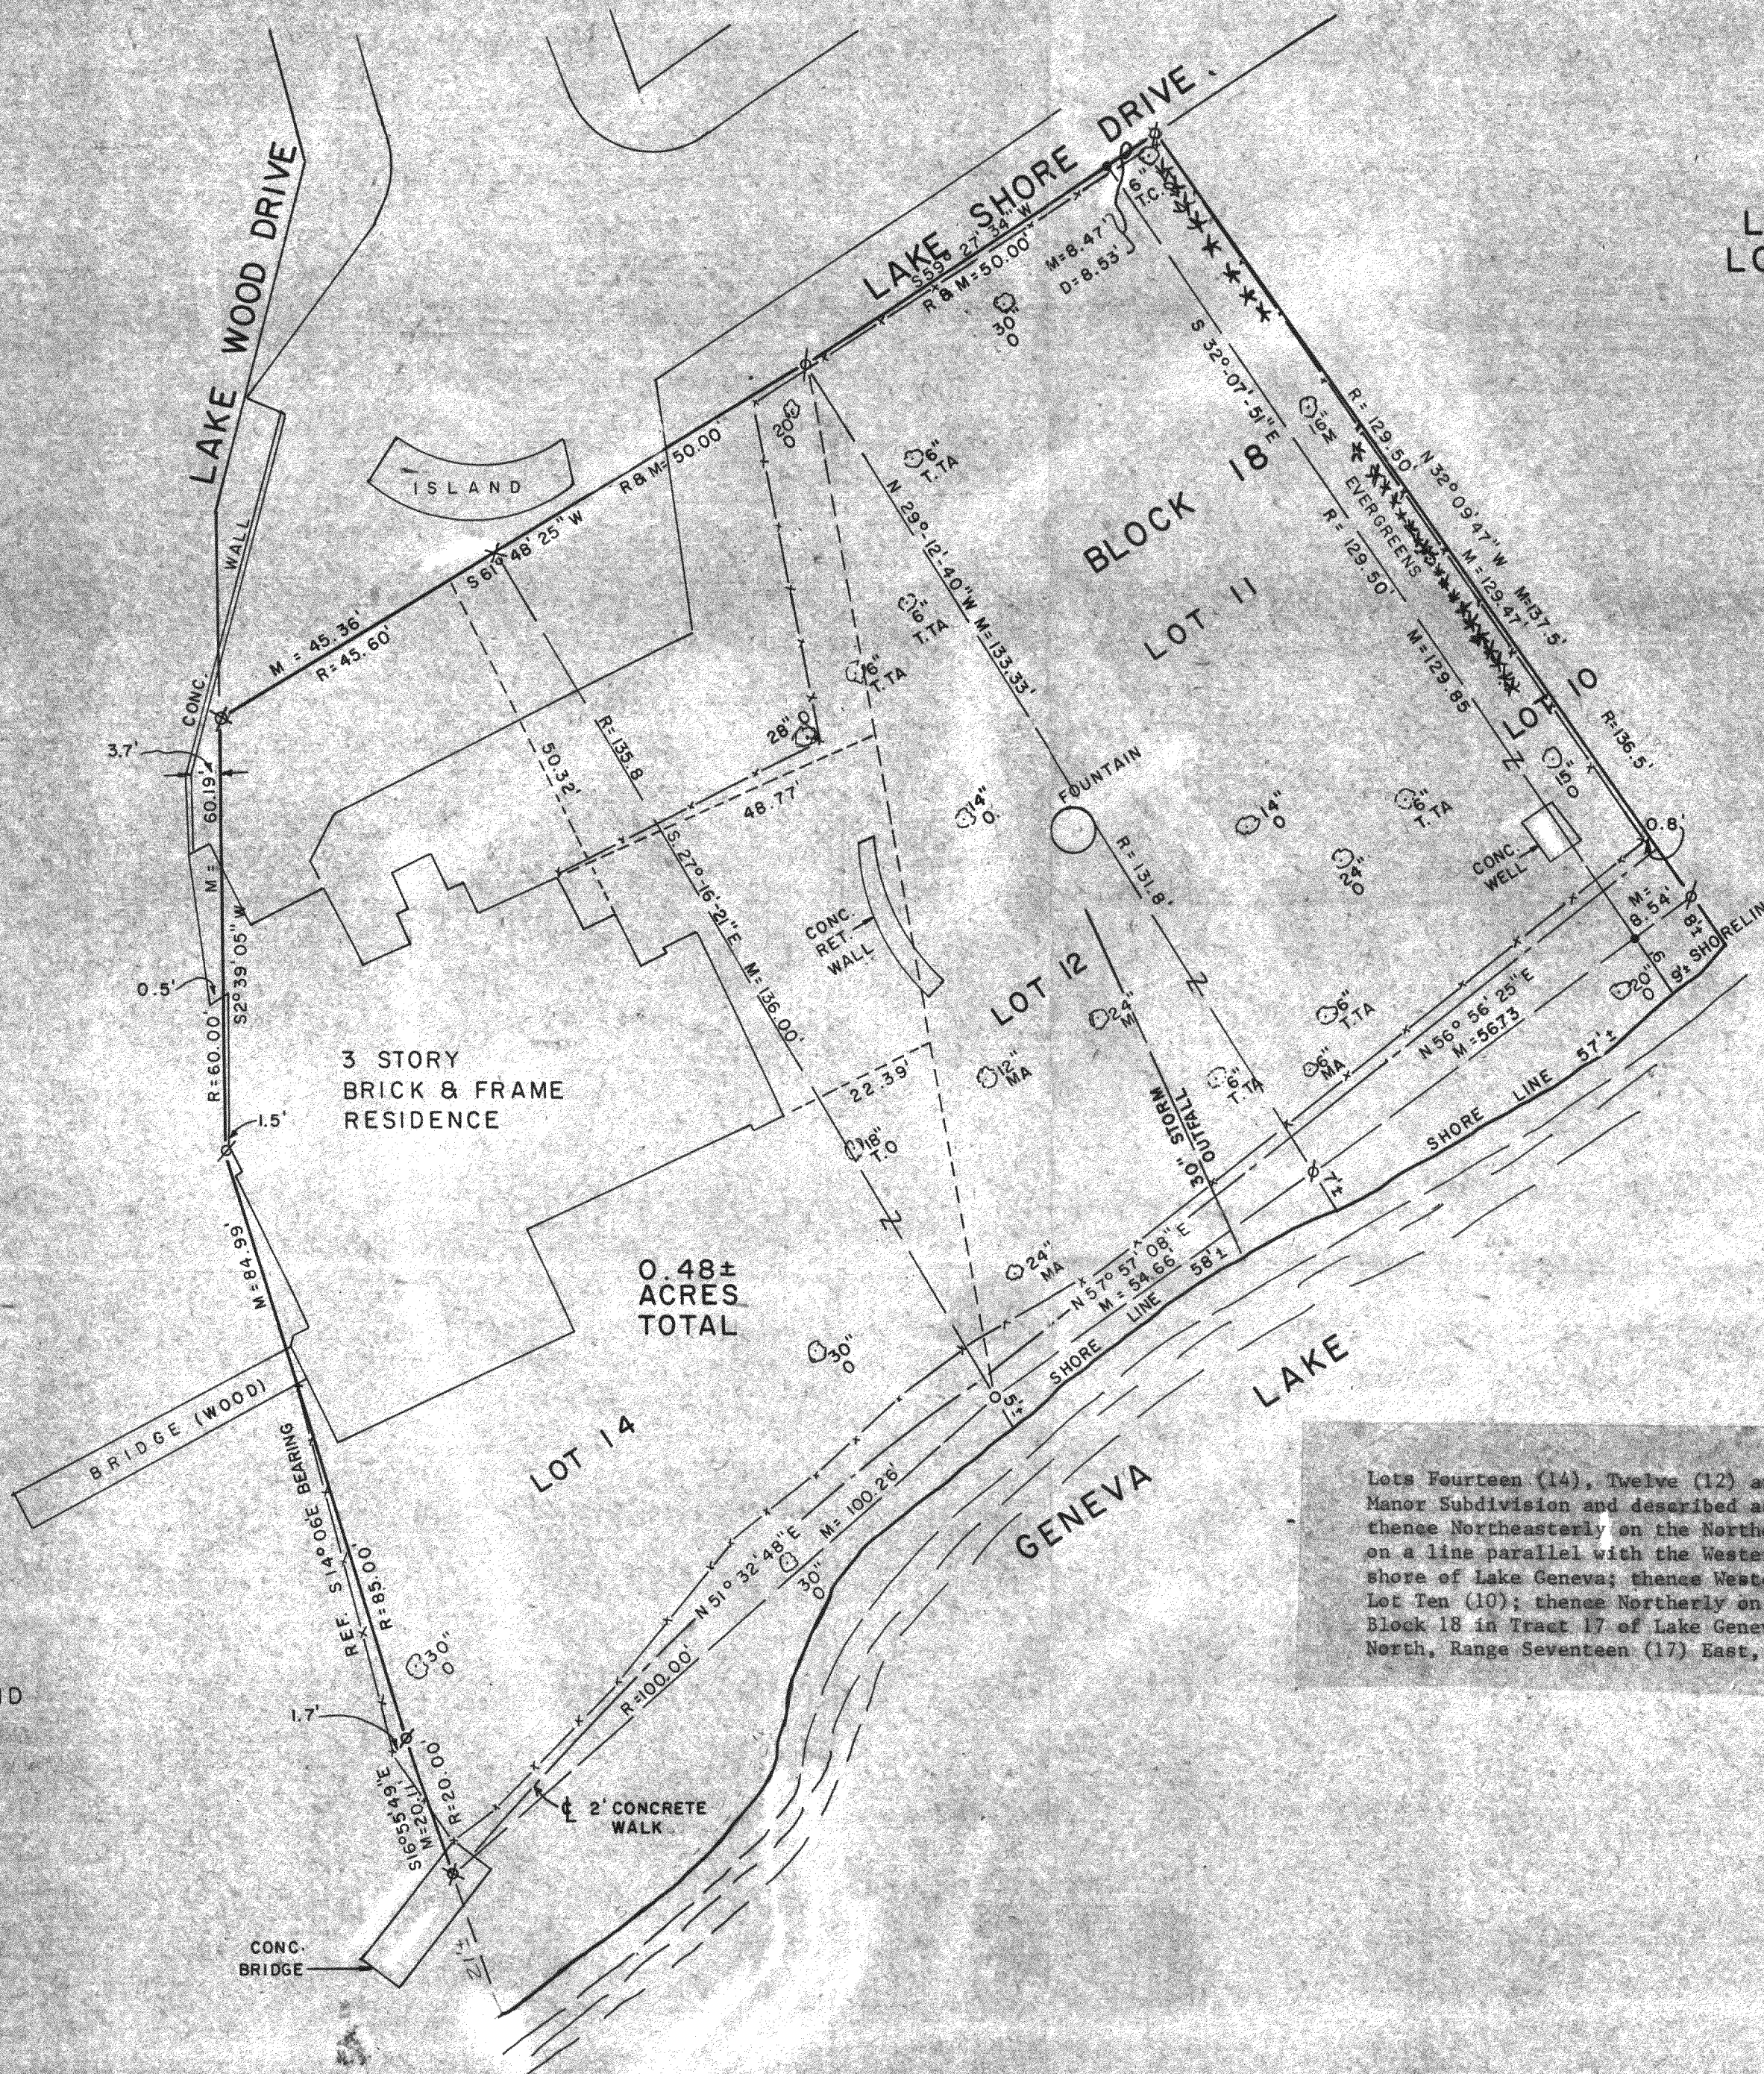

Note: Reference bearing based on the Southwesterly line of Block 10 as shown on the original recorded subdivision plat of Lake Geneva Manor assumed to be S 14° 00' E.

LEGEND

- = SET IRON ROD
- = FOUND IRON PIPE
- = SET IRON PIPE
- ⊗ = CROSS IN CONCRETE FOUND
- R = RECORDED
- M = MEASURED
- = TREE
- O = OAK
- MA = MAPLE
- TA = THORN APPLE
- C = CHERRY
- T = TWIN
- D = DEED
- X-X = WOOD PICKET FENCE
- X = SET CROSS IN CONCRETE

Lots Fourteen (14), Twelve (12) and Eleven (11) and that part of Lot Ten (10), Block 18, Lake Geneva Manor Subdivision and described as follows: Beginning at the Northwestern corner of said Lot Ten (10); thence Northeasterly on the Northerly line of Lot Ten (10) a distance of 8.53 feet; thence Southeasterly on a line parallel with the Westerly line of Lot Ten (10) a distance of 136.5 feet more or less to the shore of Lake Geneva; thence Westerly along the shore line of said Lake to the Westerly line of said Lot Ten (10); thence Northerly on the Westerly line of said Lot to the place of beginning all in Block 18 in Tract 17 of Lake Geneva Manor, a subdivision in Section Thirty-five (35), Township Two (2) North, Range Seventeen (17) East, of the Fourth (4th) principal meridian in Walworth County, Wisconsin.

Surveyors Certificate

I, Robert Scott Johnson, Registered Land Surveyor, do hereby certify that the plat shown hereon is a true and accurate survey and a true representation thereof and the exterior boundary lines and all divisions of said property have been surveyed under my direction and to the best of my knowledge and belief.


Dated This 24th day of APRIL, 1980

Robert Scott Johnson

DATE APRIL 22, 1980

DRAWN BY *Don Schauer*

CHECKED BY *D.E.J.*

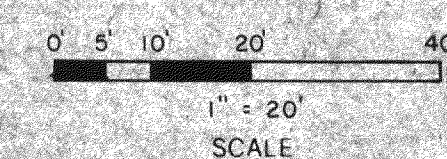

Surveyed for Abra Prentice Anderson 1972 Trust

1	STORM SEWER & CONC. WALK	11/03/80
NO	REVISIONS	DATE

donohue & associates inc.

CONSULTANTS • ENGINEERS • PLANNERS • ARCHITECTS

ES 336

7-702