


KOLB LAND CONSULTING, INC.
AND SURVEYING • SUBDIVIDING • LAND PLANNING


WHITEWATER, WISCONSIN 53190

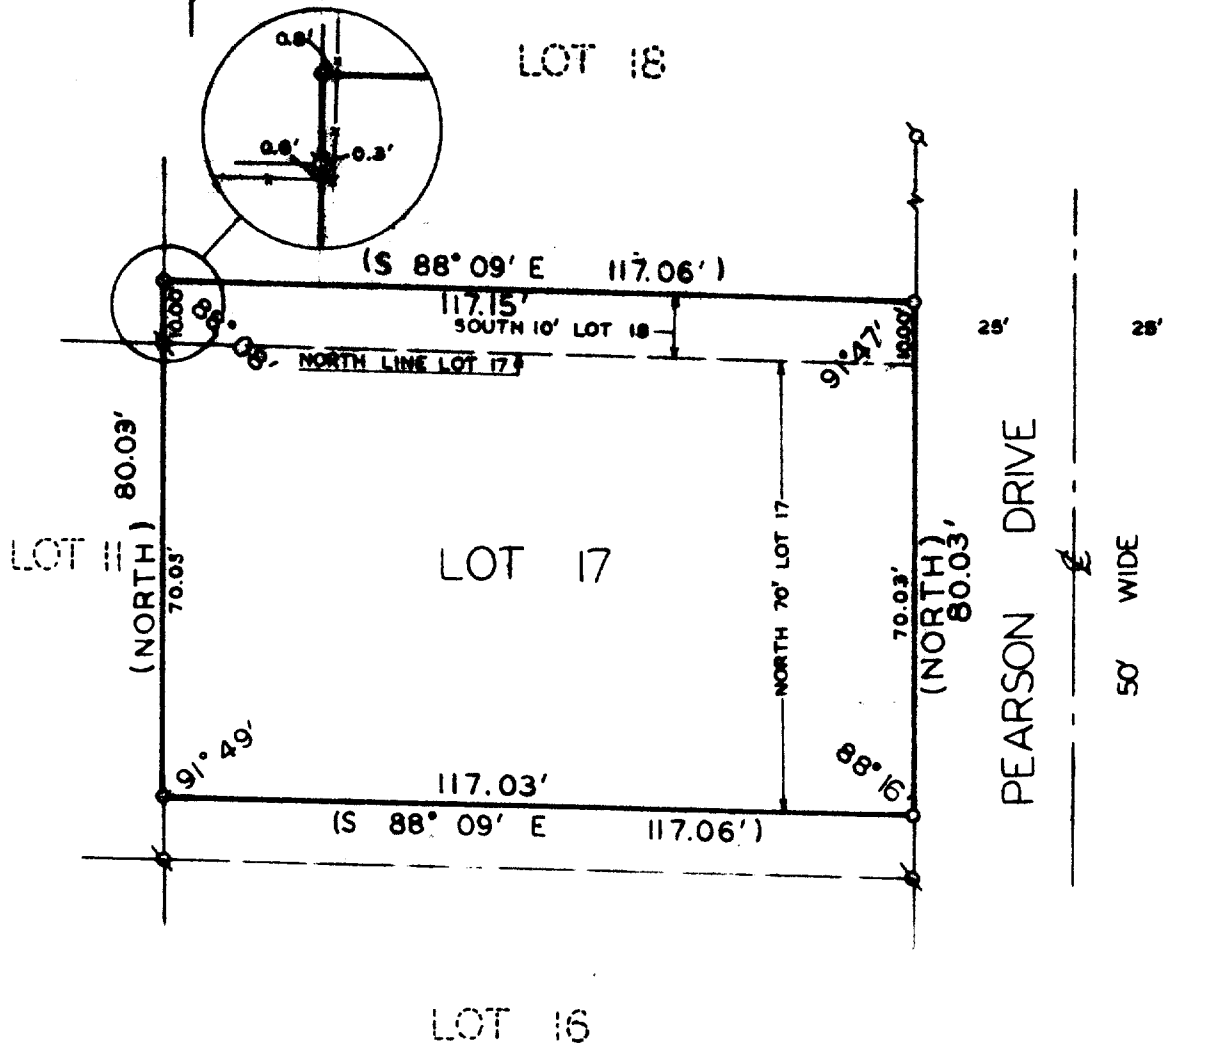

PLAT OF SURVEY OF

THE NORTH 70 FEET OF LOT 17, AND THE SOUTH 10 FEET OF LOT 18, PEARSON SUBDIVISION LOCATED IN SECTION 35, T2N, R17E, CITY OF LAKE GENEVA, WALWORTH COUNTY, WISCONSIN.

ORDERED BY: WURTZ CONSTRUCTION, INC.
100 EAST MAIN STREET
LAKE GENEVA, WISCONSIN. 53147

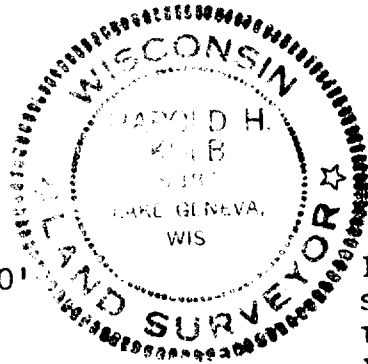

SCALE: 1"=30'

LEGEND

- o - IRON PIPE SET
 x - IRON PIPE FOUND
 — FENCE LINE
 () - RECORDED AS

I, HAROLD H. KOLB, DO HEREBY CERTIFY THAT I HAVE SURVEYED THE PROPERTY HEREON DESCRIBED ACCORDING TO THE OFFICIAL RECORDS, AND THAT THE PLAT HEREON IS A CORRECT REPRESENTATION OF THE LOT LINES TO THE BEST OF MY KNOWLEDGE AND BELIEF.

Harold H. Kolb
HAROLD H. KOLB
WISCONSIN REGISTERED LAND SURVEYOR, S- 187
DATE Dec. 5, 1980