


PLAT OF SURVEY
LOTS 3-8, BLOCK 10
LAKE GENEVA MANOR SUBDIVISION
LOCATED IN THE CITY OF LAKE GENEVA
WALWORTH COUNTY, WISCONSIN

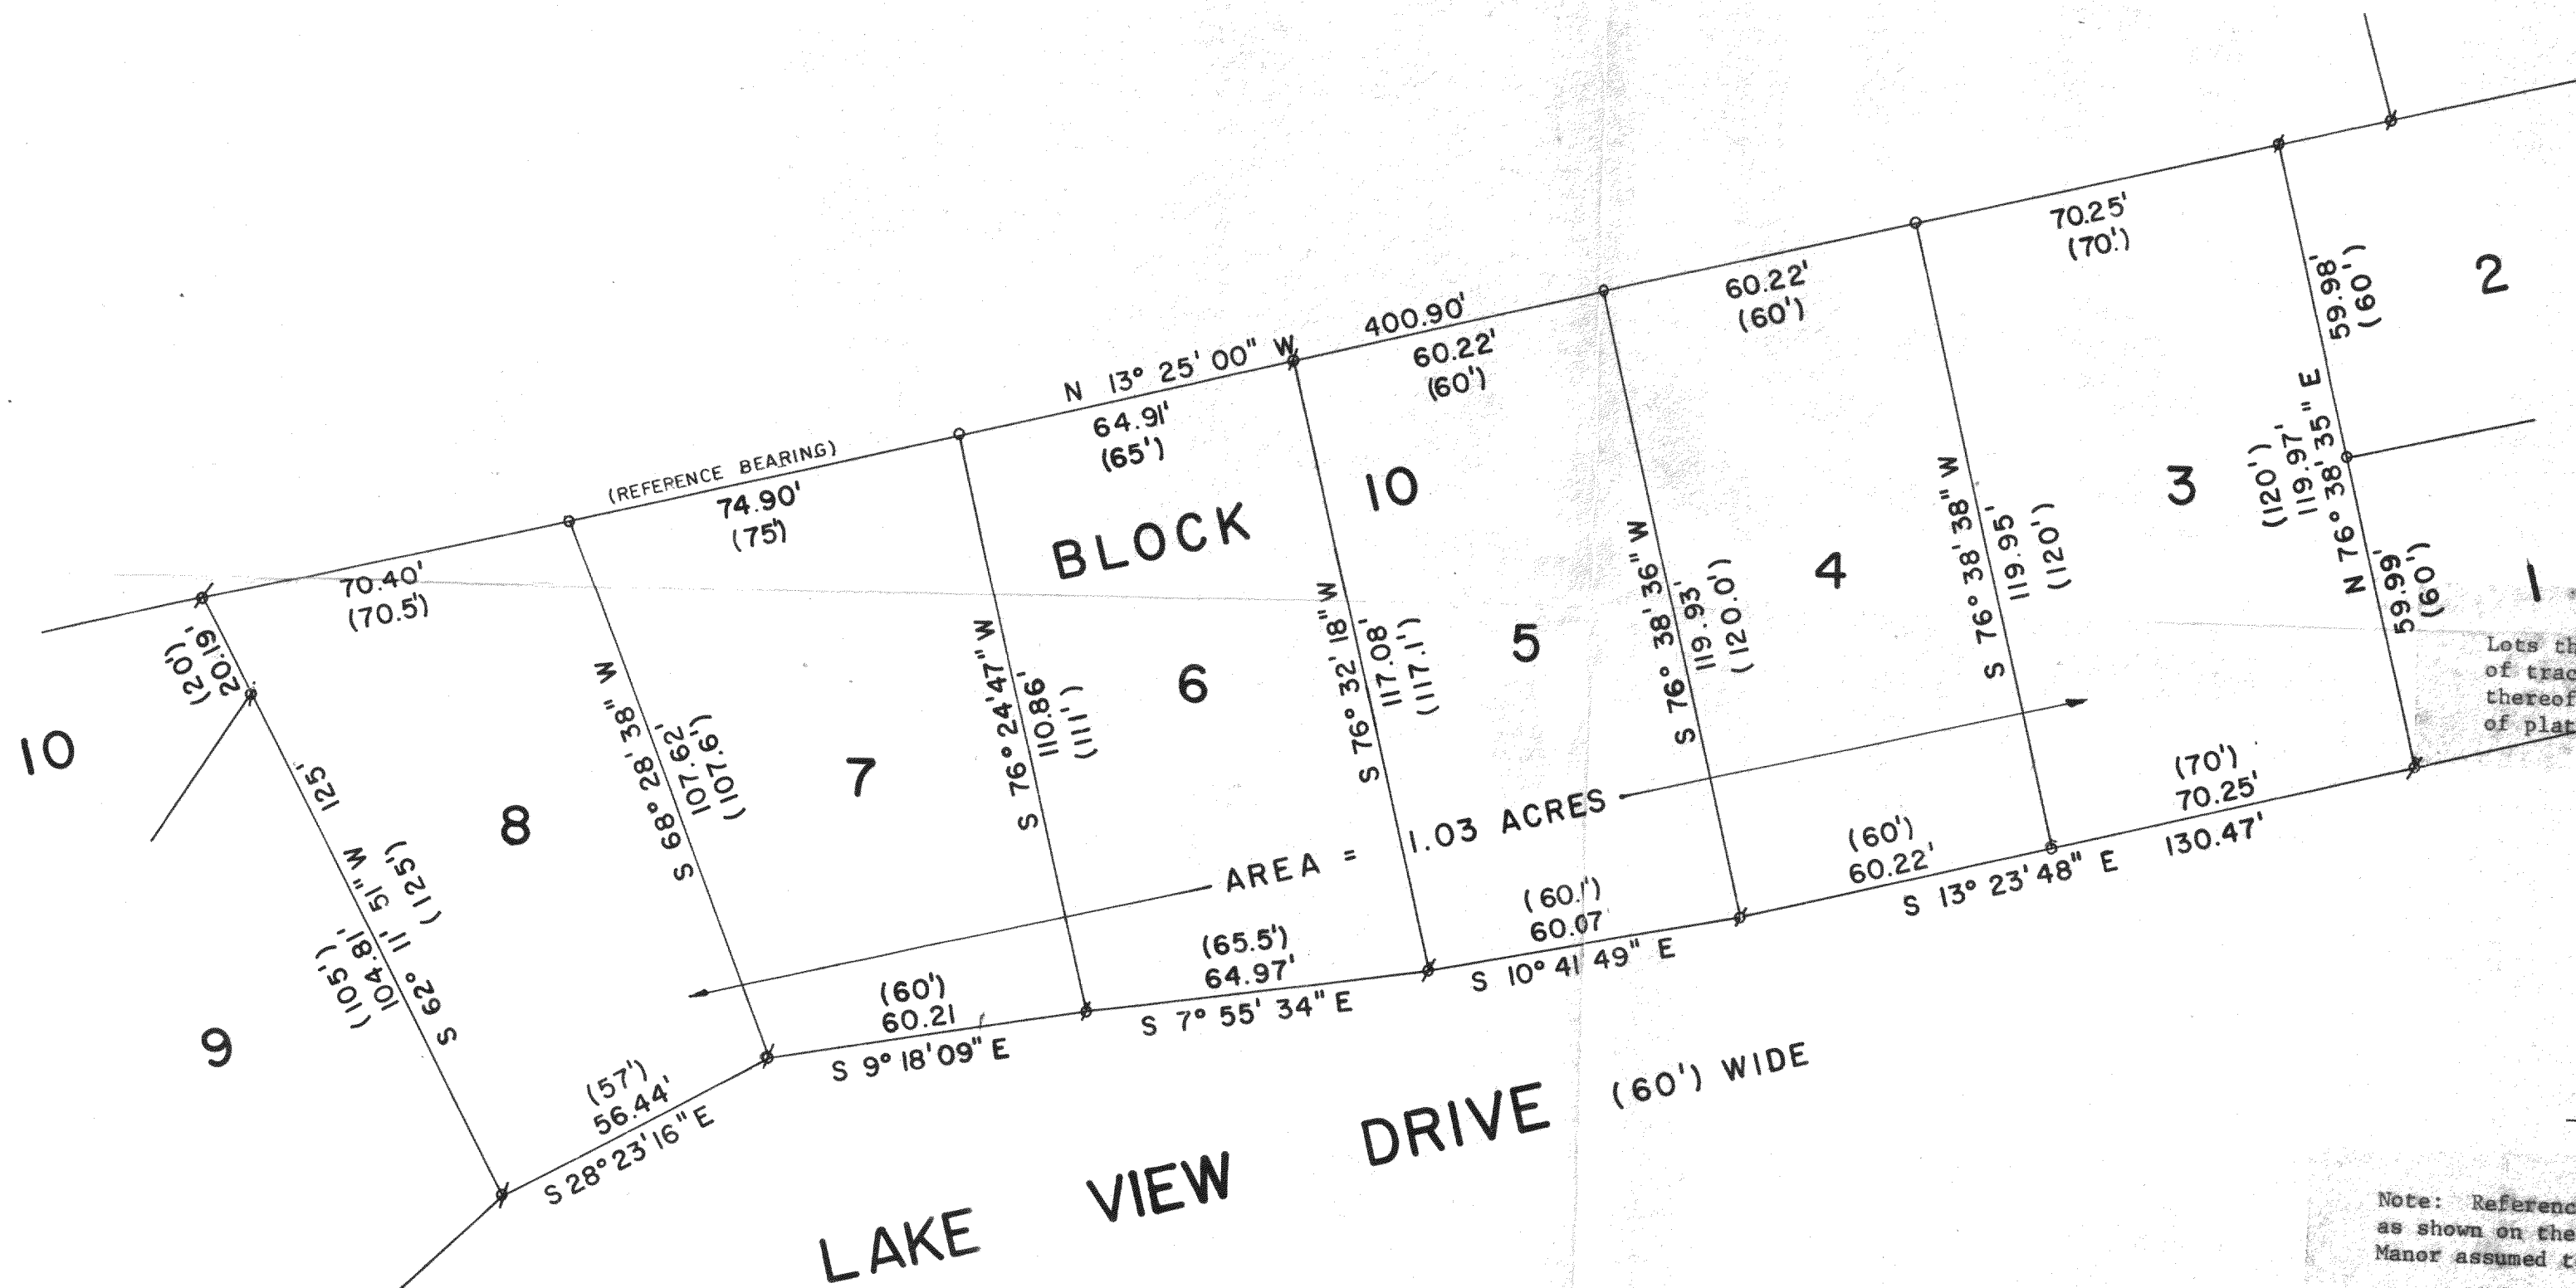

LEGEND

- ⊗ FOUND IRON PIPE
- SET IRON PIPE 1 1/2" x 36"
- () RECORDED DISTANCES & BEARINGS

DESCRIPTION

Lots three (3), four (4), five (5), six (6), seven (7) and eight (8), of tract seventeen (17), of Lake Geneva Manor, as shown on the plat thereof recorded in the office of the Register of Deeds in Vol. nine (9) of plats, on Page fifty-two (52), Walworth County, Wisconsin.

Note: Reference bearing based on the Southwesterly line of Block 10 as shown on the original recorded subdivision plat of Lake Geneva Manor assumed to be S 13°-25' E.

Note: Recorded distances based on the original recorded subdivision plat of Lake Geneva Manor.




Surveyors Certificate

I, Robert Scott Johnson, Registered Land Surveyor, do hereby certify that the plat shown hereon is a true and accurate survey and a true representation thereof and the exterior boundary lines and all divisions of said property have been surveyed under my direction and to the best of my knowledge and belief.

Dated This 3RD day of NOVEMBER 1980

Robert Scott Johnson

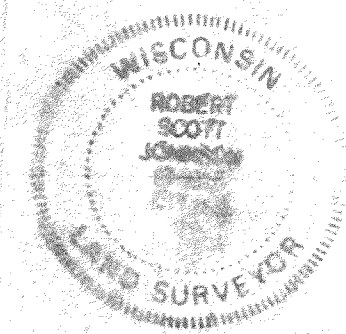

DATE	OCTOBER 28, 1980				
DRAWN BY	M. J. JENSEN				
CHECKED BY			NO.	REVISIONS	DATE

donohue & associates inc.
 CONSULTANTS • ENGINEERS • PLANNERS • ARCHITECTS

ES-355-B

PROJECT NO.
10783.000

ALL RIGHTS RESERVED