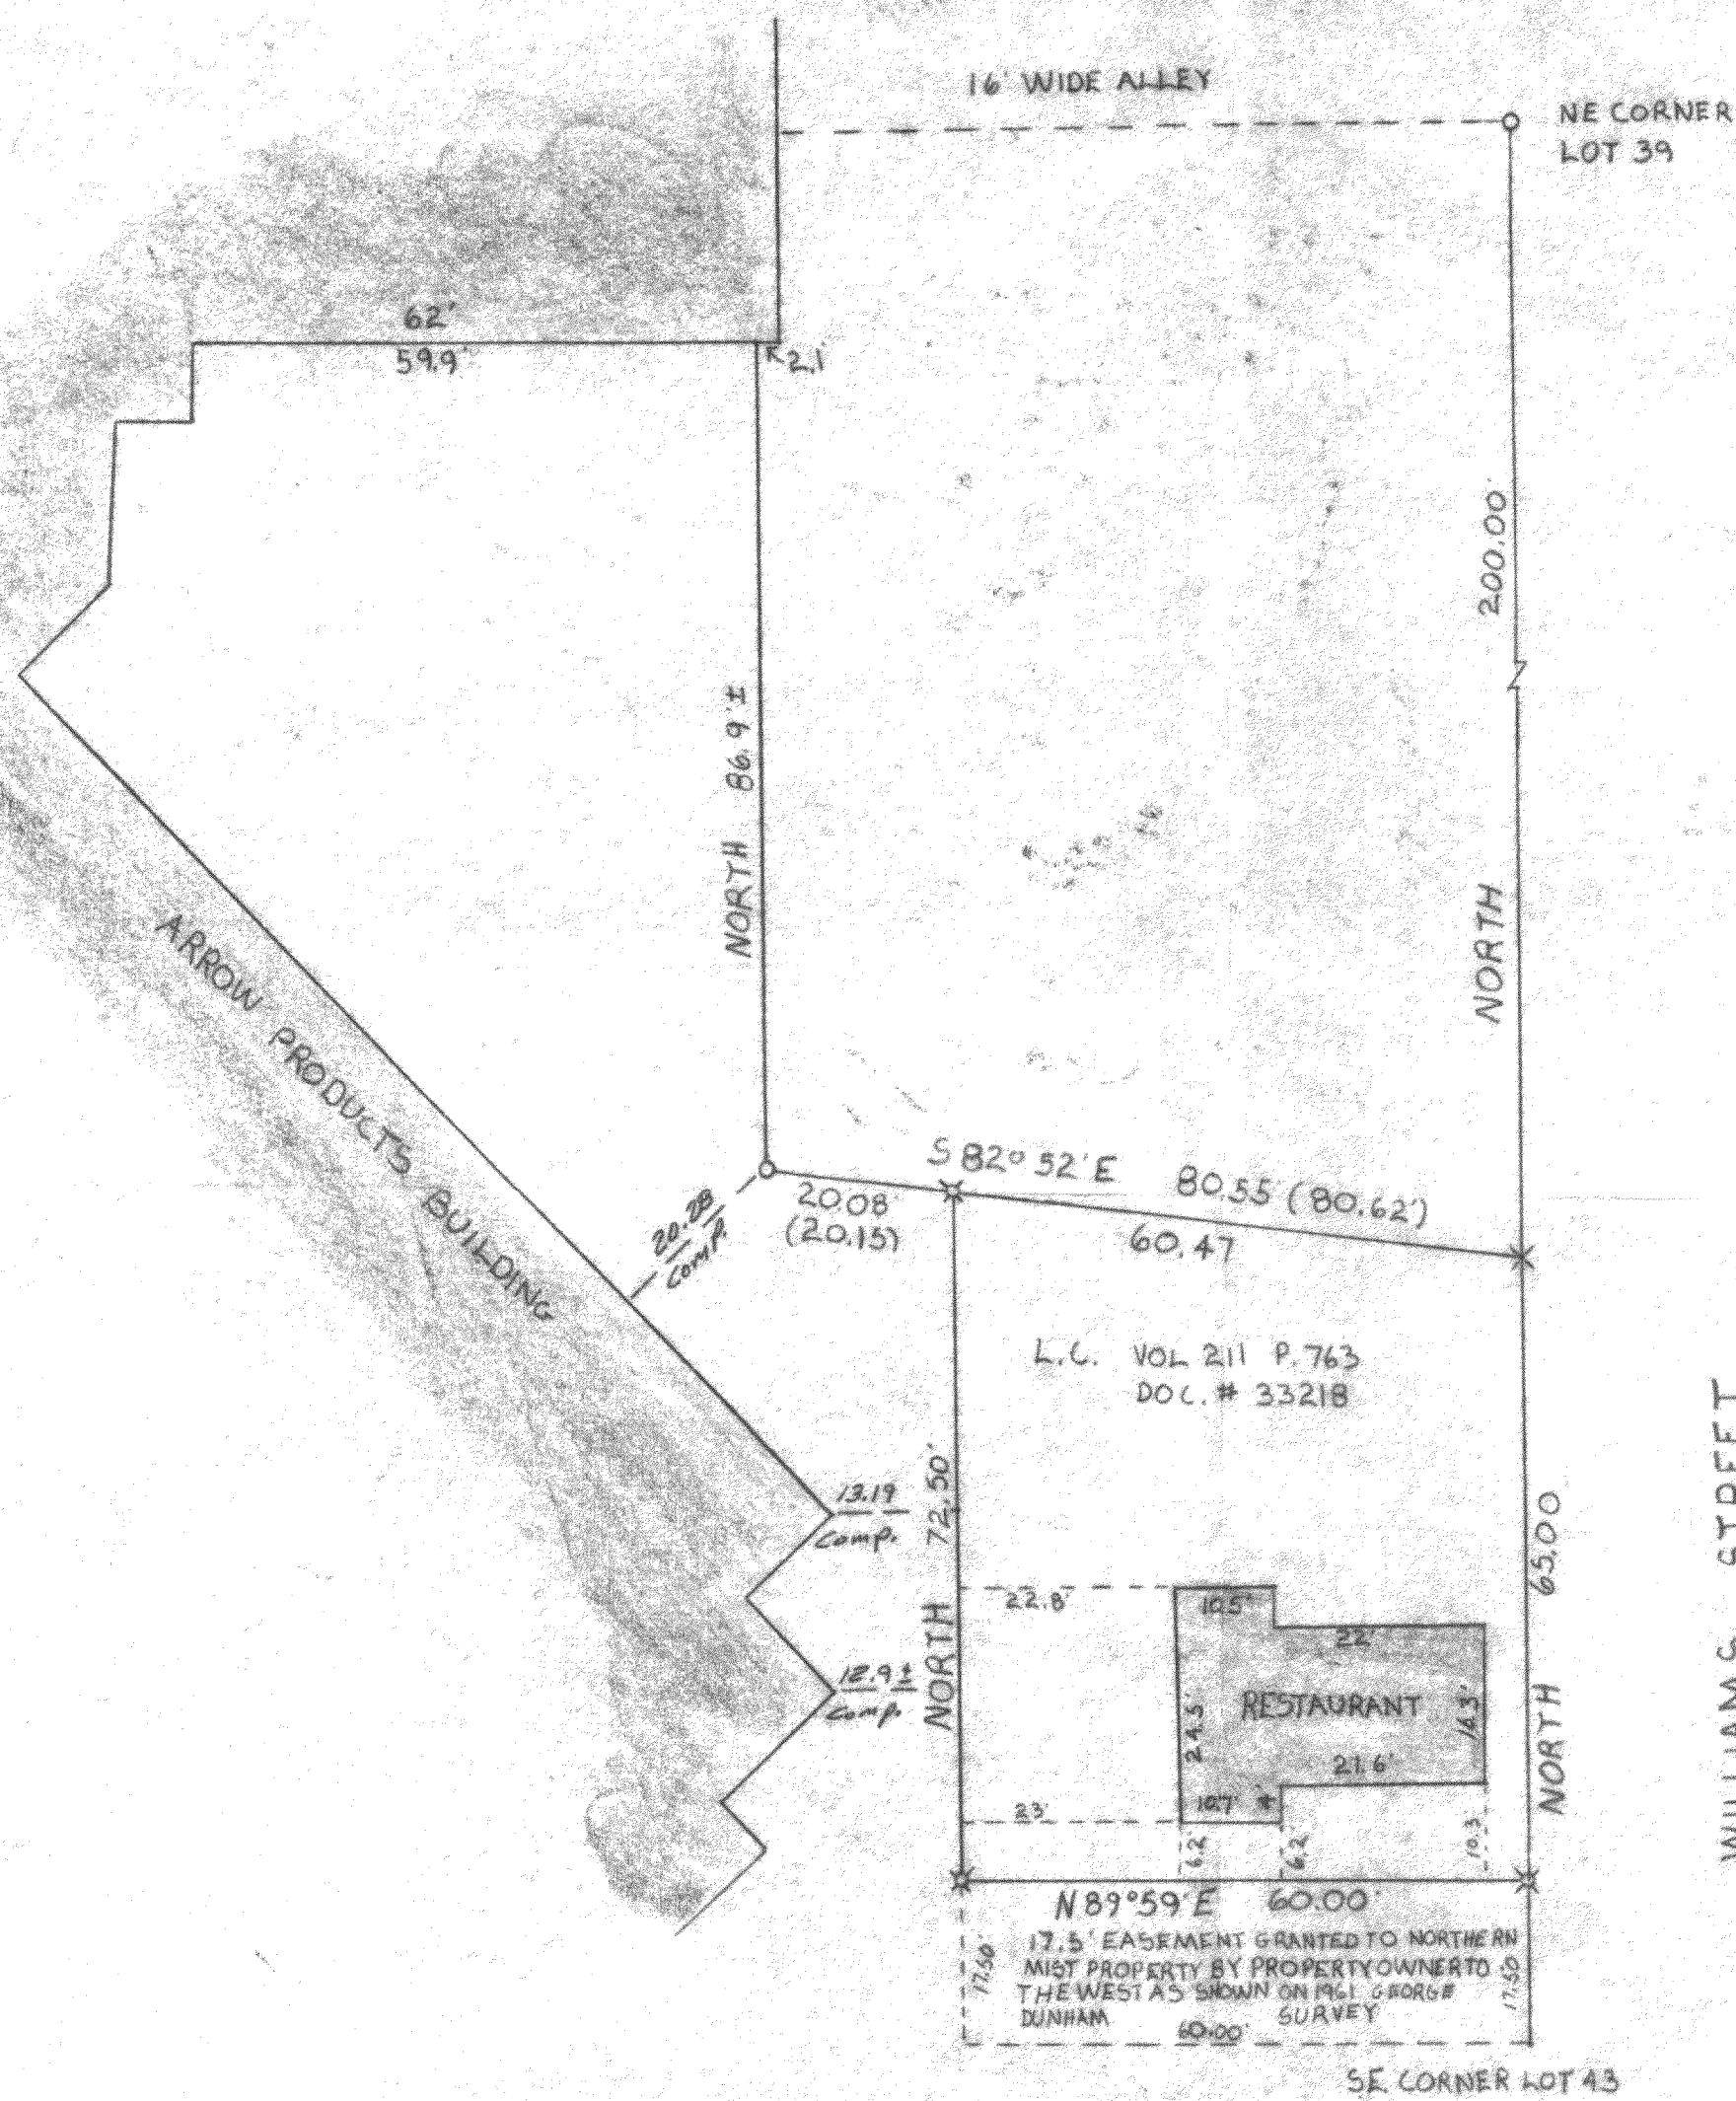


LEGEND

- ~ 1" IRON PIPE FOUND
 - ✕ ~ RK. NAIL SET
 - ✕ ~ CHISELED CROSSCUT FOUND
 - () ~ RECORDED AS
 - COMP. = COMPUTED DISTANCE
- JENSEN SURVEYING & MAPPING
P.O. BOX 322
ELKHORN, WISCONSIN 53121

PLAT OF SURVEY OF

BUILDING LOCATIONS OF RESTAURANT AND
ARROW PRODUCTS IN LOTS 40-41-42-43 OF
RICH'S ADDITION TO THE VILLAGE (NOW CITY) OF
LAKE GENEVA, WALWORTH COUNTY, WISCONSIN

Thomas P. A. Jensen
SURVEYOR

SCALE 1" = 20'

DATE FEB. 26, 1980

