
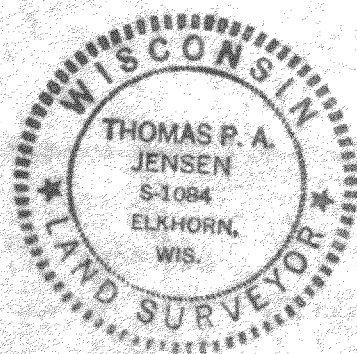


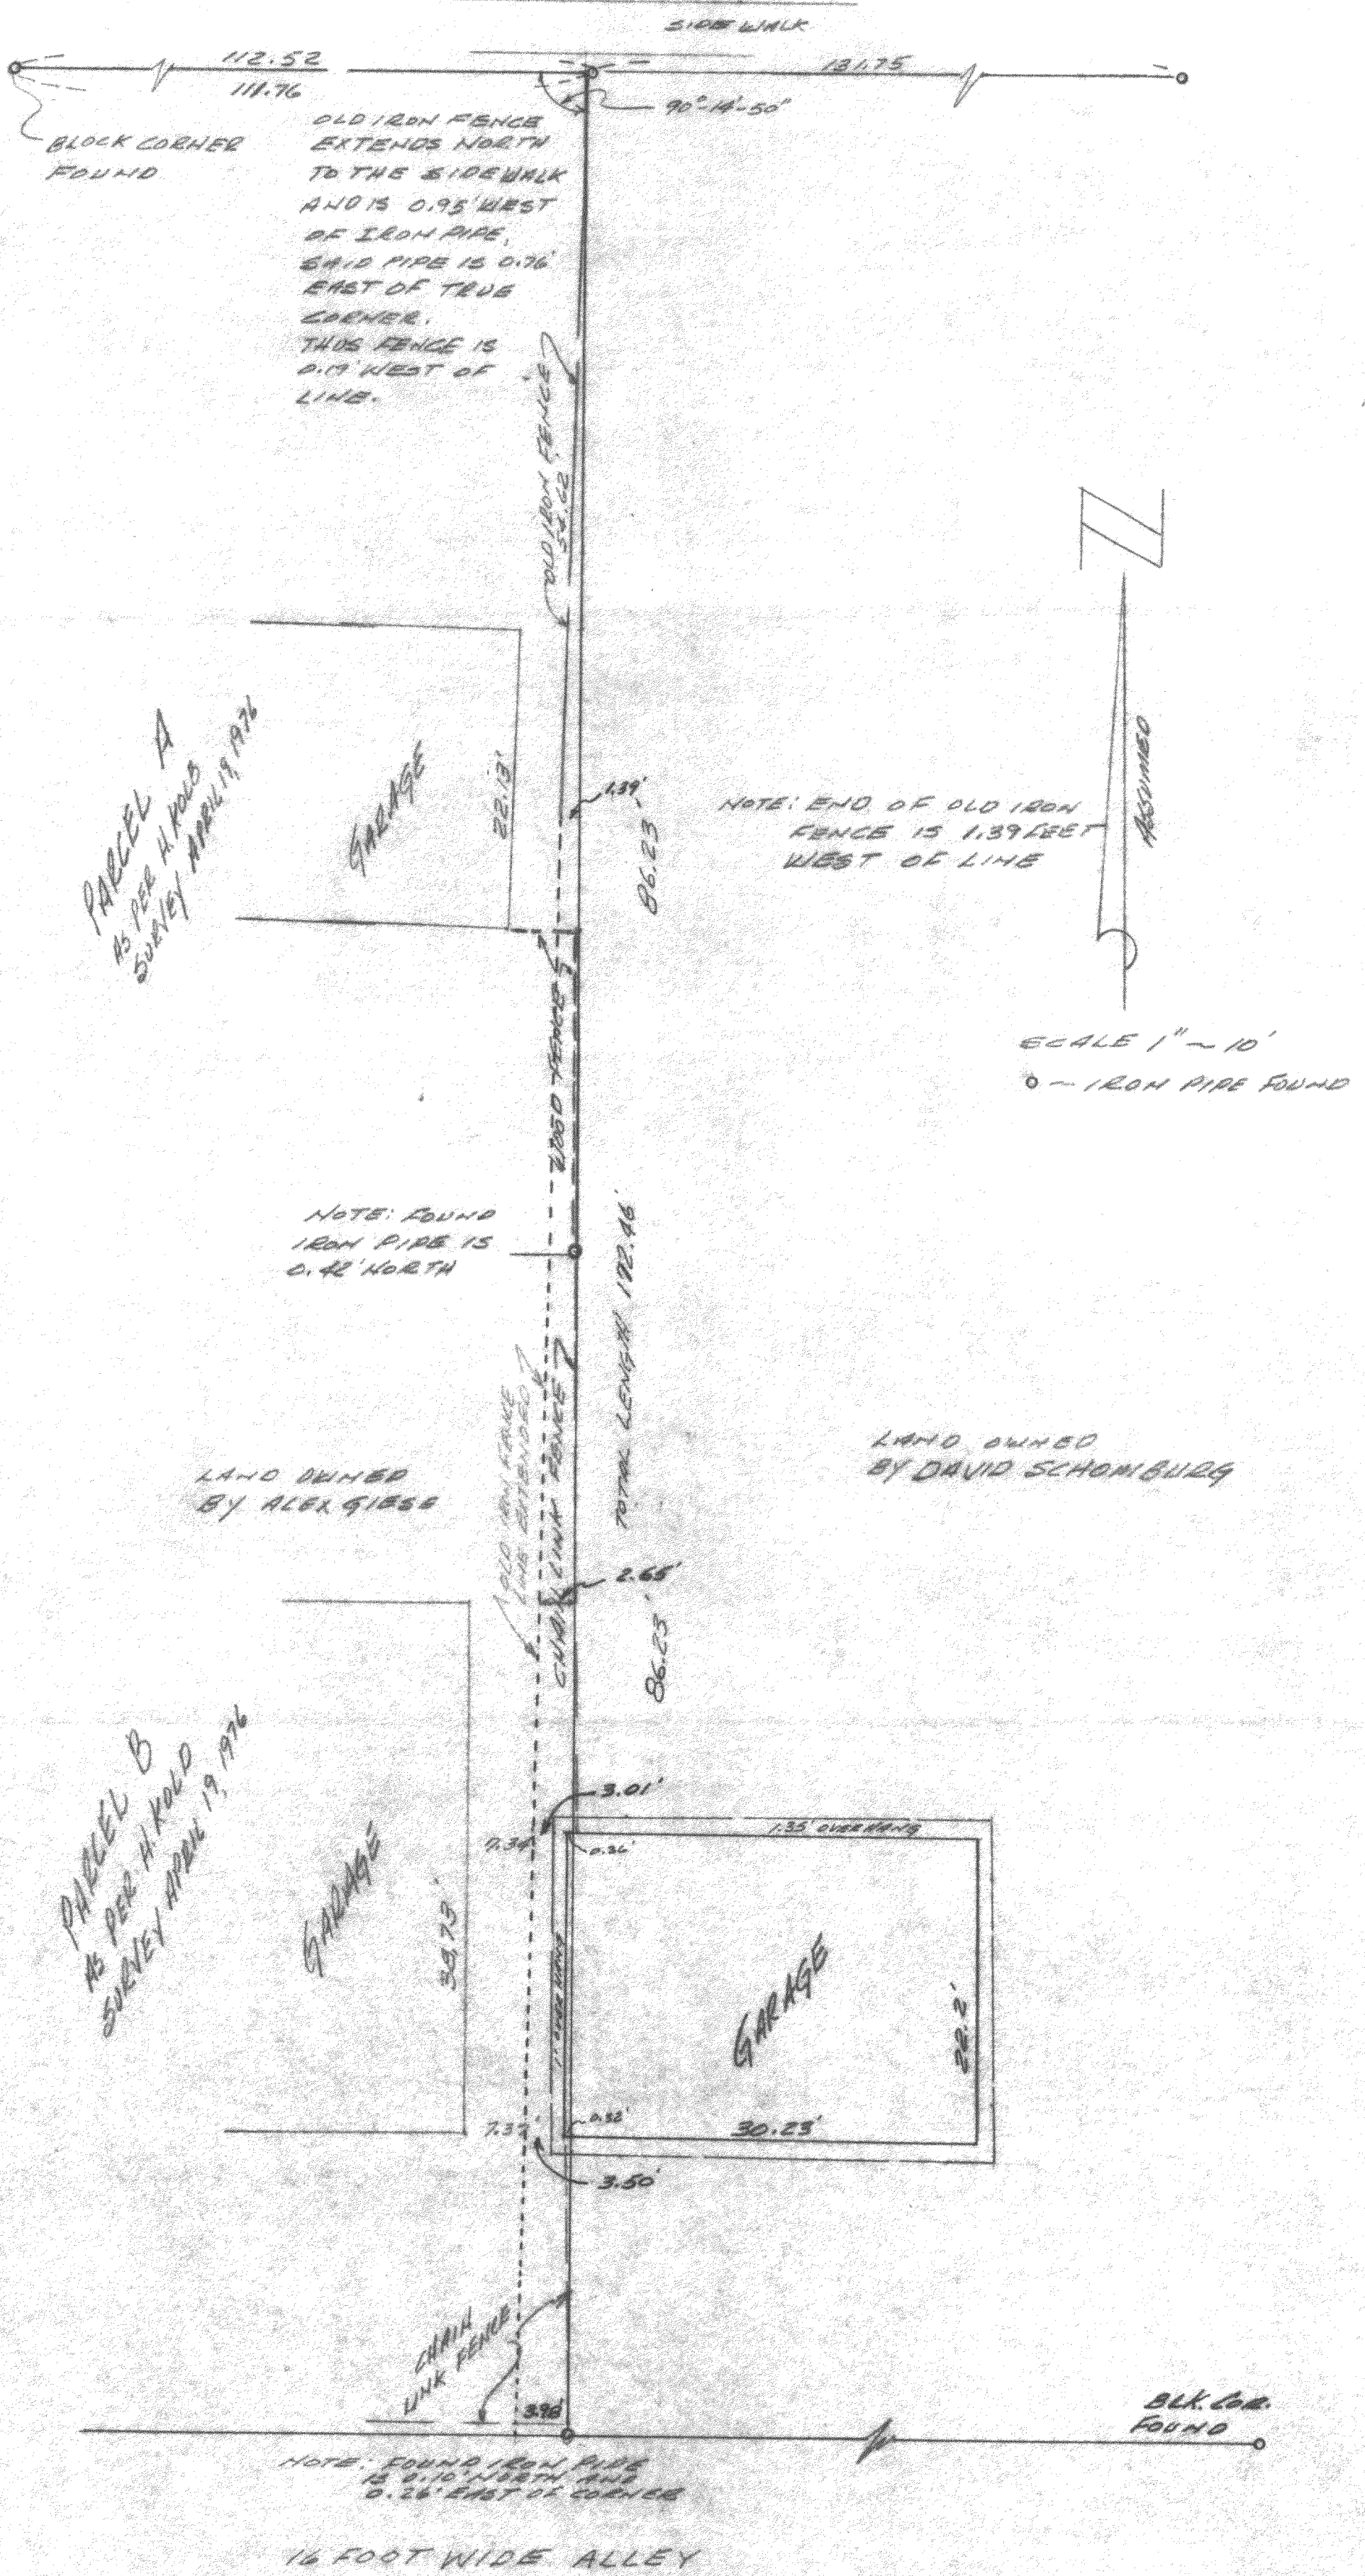

PLAT OF SURVEY OF A
PURPORTED PROPERTY LINE
BEING THE WEST LINE OF THE
EAST 10 FEET OF LOTS 5 & 6
BLOCK 23, ORIGINAL PLAT TO
THE CITY OF LAKE GENEVA,
WALWORTH COUNTY, WIS.

I CERTIFY THAT I HAVE SURVEYED THE
ABOVE DESCRIBED PROPERTY LINE AND THAT
PLAT SHOWN HEREON IS AN ACCURATE SURVEY
AND A TRUE REPRESENTATION THEREOF AND
CORRECTLY SHOWS THE BOUNDARY LINE
AND ALL IMPROVEMENTS THEREON.
SEPT. 14, 1981

Thomas P. A. Jensen
THOMAS P. JENSEN S-1084
JENSEN SURVEYING
& MAPPING
ELKHORN, WISCONSIN