


KOLB LAND CONSULTING, INC.  
LAND SURVEYING • SUBDIVIDING • LAND PLANNING

LAKE GENEVA, WISCONSIN 53147

WHITEWATER, WISCONSIN 53190

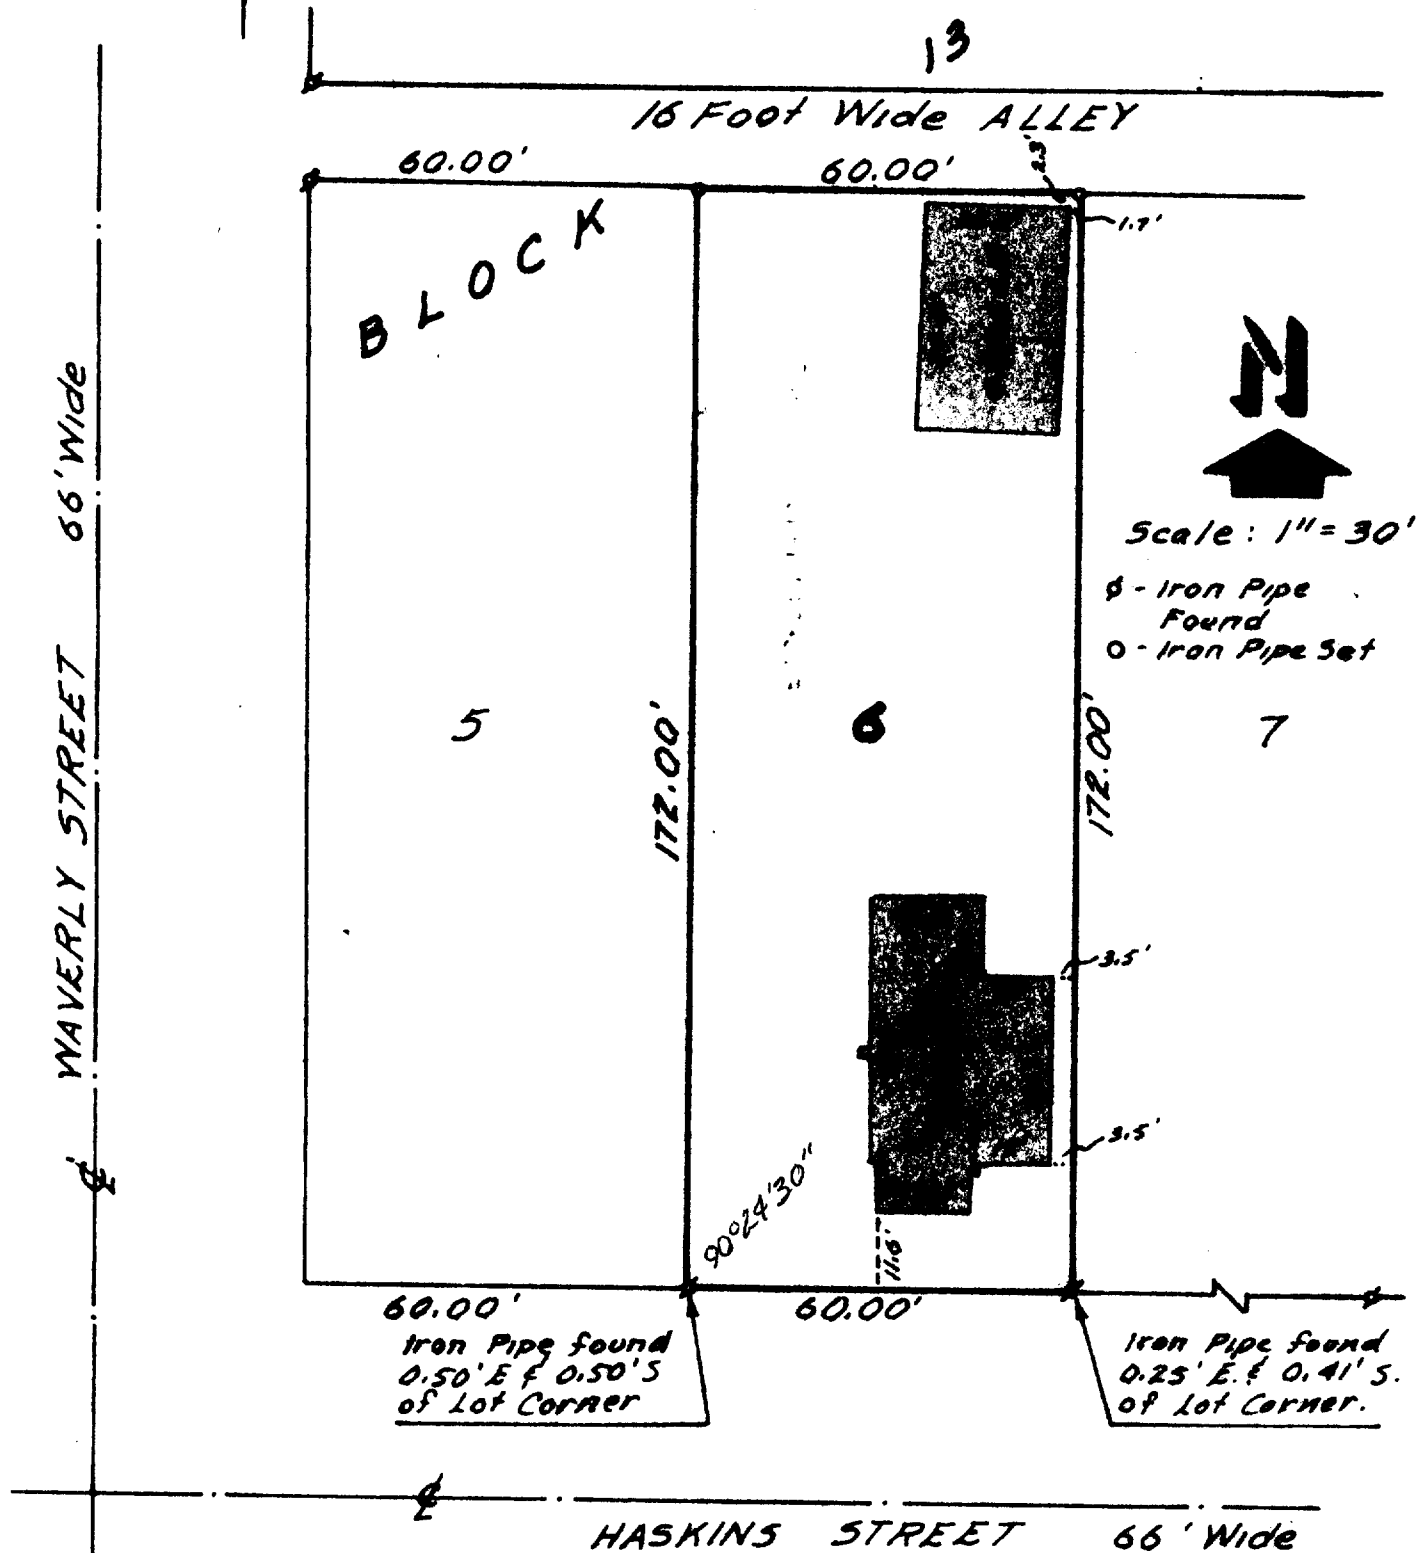


PLAT OF SURVEY OF

LOT 6, BLOCK 13, GENEVA LAKE CRAWFORD MANUFACTURING  
COMPANY ADDITION TO THE CITY OF LAKE GENEVA, WAL-  
WORTH COUNTY, WISCONSIN.

I, HAROLD H. KOLB, DO HEREBY CERTIFY  
THAT I HAVE SURVEYED THE PROPERTY HERE-  
ON DESCRIBED ACCORDING TO THE OFFICIAL  
RECORDS, AND THAT THE PLAT HEREON IS A  
CORRECT REPRESENTATION OF THE LOT LINES  
AND THE PRINCIPLE LINES OF THE BUILD-  
INGS THEREON.

*Harold H. Kolb*

WISCONSIN REGISTERED LAND SURVEYOR, S-187  
DATE OCTOBER 5, 1982

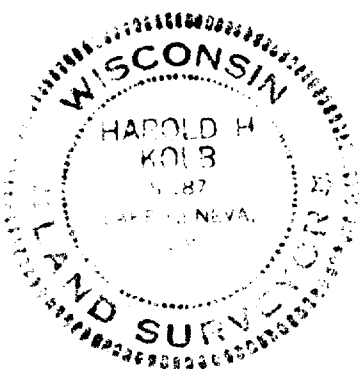

26C-52

7-715-K