

ROBERT BRAUER LAND SURVEYING

residential

agricultural



commercial

FONTANA, WI.

(414) 275-8359

PLAT OF SURVEY

Of Lot 39 and Lot 40 of Watson's Boulevard Addition to the City of Lake Geneva, Geneva Township, Walworth County, Wisconsin.

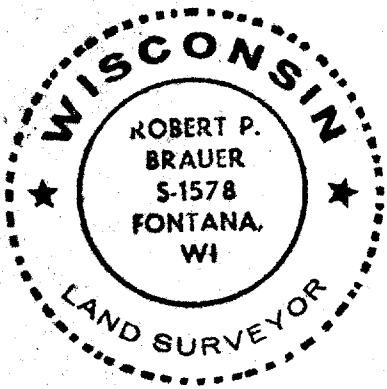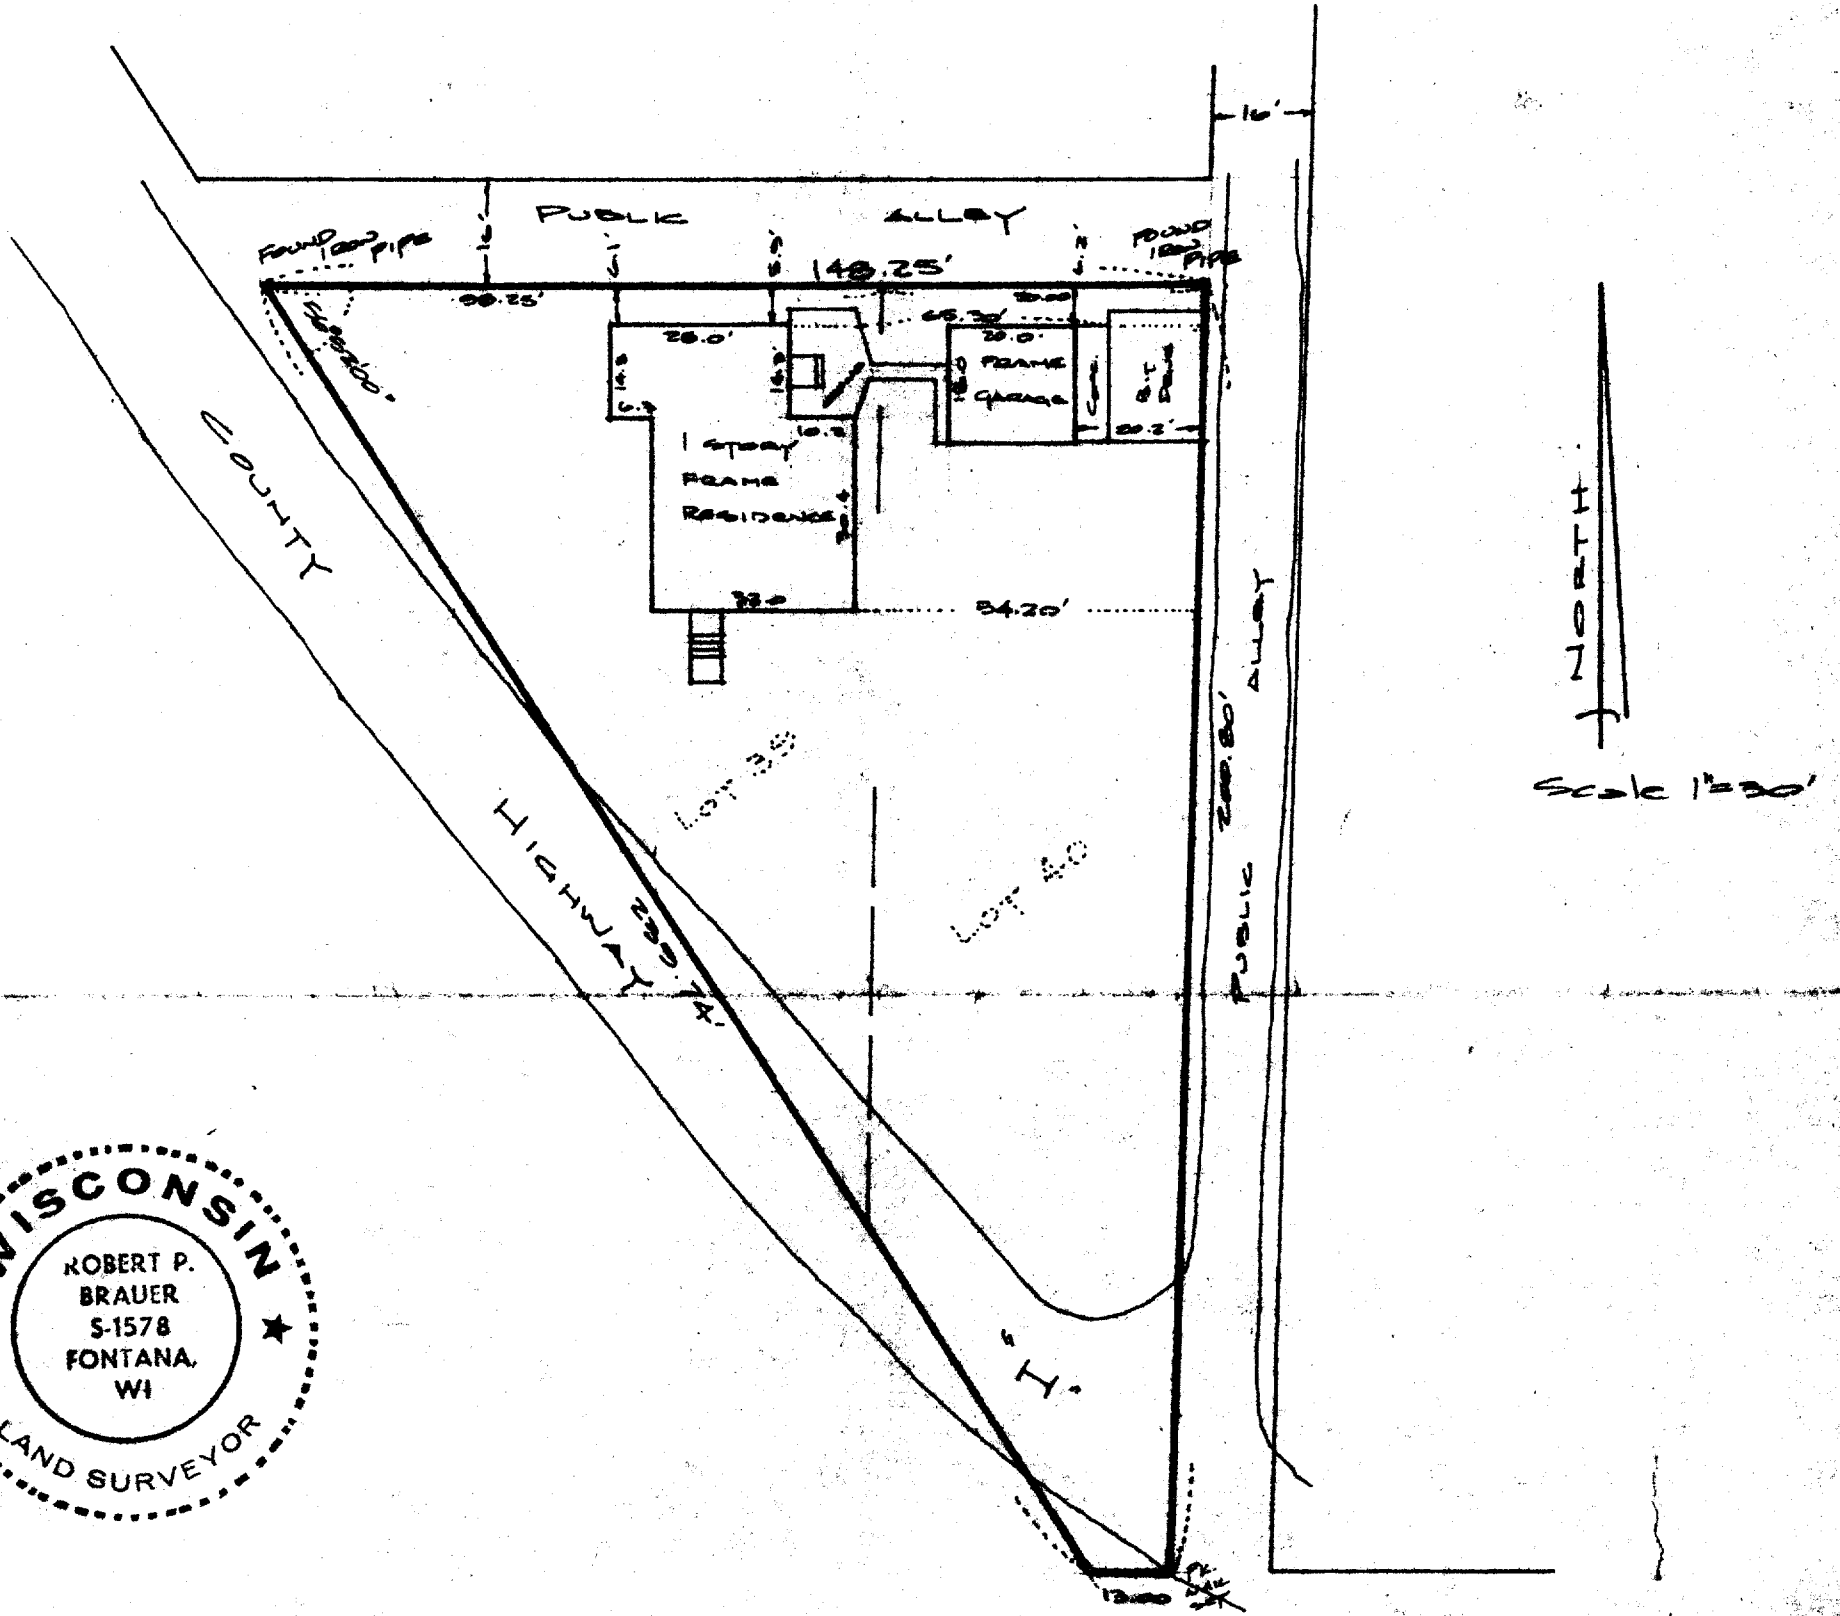

I HEREBY CERTIFY THAT I HAVE SURVEYED THE ABOVE DESCRIBED PROPERTY AND THE ABOVE MAP IS A TRUE REPRESENTATION THEREOF AND SHOWS THE SIZE AND LOCATION OF THE PROPERTY, ITS EXTERIOR BOUNDARIES, THE LOCATION OF ALL VISIBLE STRUCTURES AND DIMENSIONS OF ALL PRINCIPLE BUILDINGS THEREON, BOUNDARY FENCES, APPARENT EASEMENTS, ROADWAYS AND VISIBLE ENCROACHMENTS, IF ANY.

THIS SURVEY IS MADE FOR THE PRESENT OWNERS OF THE PROPERTY, AND ALSO THOSE WHO PURCHASE MORTGAGE, OR GUARANTEE THE TITLE THERETO WITHIN ONE YEAR FROM DATE THEREOF.

DATED AT Fontana, WI THIS 14th DAY OF April 1981

Robert P. Brauer

ROBERT P. BRAUER Registered Land Surveyor 1978

No. 8122

210 B-28

7-717